County: <u>Solivat</u> Permit #: <u>GWA 34360</u> Driller: <u>Sore</u> DA <u>Buva</u> A Driller: <u>Sore</u> DA <u>Buva</u> A Driller: <u>Sore</u> DA <u>Buva</u> A Driller: <u>Sore</u> DA <u>Buva</u> A Date drilling completed: <u>429-05</u> State Law requires that this report be prepared by the lice Department at the above address within 30 days of comp Information on Well Owner (Landowner if borehole is not for a water with) A	n, MS 39225 261- 5210 2- 5228 (fax) 2- sense holder responsible for the sense 2- sense holder responsible for the sense holder responsible for the sense 2- sense holder responsible for the sense hol	For Office Use Only:         Aquifer:         Well #:       9.133         L. S. Elevation:         E-log #:         he work and filed with the or borehole.         rehole Location         Longitude 9 0 ° 5 4 ' 951'"
Owner Name <u>740</u> Mailing Address: <u>313</u> <u>Jalmun</u> – Latterfield Rd <u>Bennit</u> <u>NLS</u> . <u>3872.5</u> City State Zip Code Telephone No. <u>662</u> ) <u>721-6200</u>	45 Method of Lat/Long (circle on USGS quad, Hand-held <u>SW 45W</u> 4 Sec_ <u>33</u> Distance Direction <u>B</u> Miles	in the conventional Survey, $56^{\circ}$ <u>GPS, Survey-grade GPS</u> <u>Twn 21 N Rng 7W</u> Nearest Town of <u>B-e 71 0 17 M S</u>
Well / Bore		
Date drilling started: ¥-2f-5 Date drilling completed: ¥-19-6 Hole depth: 120 Hole diameter: 28"         Location of the source of any surface water used for drilling: <u>7 + + i c a + i n mall 144 E</u> Method of dosing and volume of Chlorine used in drilling and development         Logs run (circle all applicable): No log run Electric Gamma Ray Density Sonic Neutron Other:		
Seismic Survey Other (describe) <u>The add to Tain Manager</u> If drilling is not related to water well construction, skip the remainder of this block		
Purpose of Well (check one): Home Industrial Public Supply Inrigation Fish Culture Other:		
If a flowing well, method of flow regulation: Valve Other (describe)		
Static Water Level: <u>25</u> feet above or below (circle one) and surface Date measured: <u>4-30-09</u>		
Method of Measurement (circle one) steel tape electric tape air line other:		
Well depth: <u>70</u> Well grouted to a depth of <u>6</u> feet Typ Casing length: <u>80</u> feet Casing diameter: <u>16</u> Screen length: <u>40</u> feet Screen diameter: <u>16</u> Screen slot size: <u>50</u> inches Setting depth: From	e of grout (circle one): Near inches Type of casing: inches Type of screen:	PVC i PVC
-		
Type of completion (circle all applicable): Gravel packed Underreamed Telescoped Open hole Natural Development Other (describe):		
Other (describe):		
Top of lap pipe or reduction in casing: feet. If telescopea or more inan one screen, describe on next page Form: QLWR-SWR-1A (04/0		
		RECEIVED JUN 0 2 2009
BY: OLWR		


);

and the first of the

, ,**(** , , \* ,

Description of formations encountered must be provided for all

## The sketch below only required for water wells

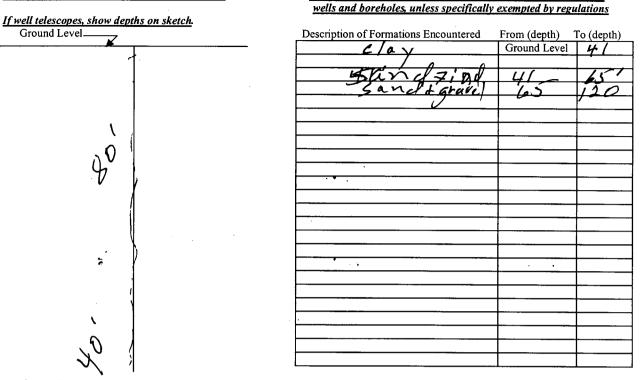

If more than one screen, show location of each on sketch

Sketch the property layout and include the following:	1) the well location; 2) any permanent structures on the property that may
aid in locating the well; 3) any roads, pow	wer lines, or other items that may aid in locating the property and the well;
4) a north arrow.	
1 ttonl	
	Benoitnos
T	
1 Sector	7
	/
V	
	1
Landowner Name: TVUV15 Sat	
Landowner Name: $\frac{7}{7}\frac{7}{4}\frac{7}{5}\frac{5}{5}\frac{5}{4}\frac{7}{7}$	<i>F H &amp; H //</i>
<u> </u>	Form: OLWR-SWR-1A (04/08)

I certify that the well/borehole was drilled, constructed, and completed in accordance with all applicable requirements of the Mississippi Department of Environmental Quality and the Mississippi Department of Health regulations, if applicable, and state

laws. Print Name of Responsible Licensee and License No. - 4-27-69 Signature of Licensee 00

RECEIVED JUN 0 2 2009 BY: OLWR

STATE WE	STATE WELL REPORT		
County: <u>Bolifuu</u> Parmit #:         Permit #:       Pump Installer's         Driller:       COOK DFilling Contract       Mississippi Department         Office of Land at       P.O. H         Date completed:       477.09       (601)	For Office Use Only:         of Environmental Quality         nd Water Resources         Sox 2309         MS 39225         961-5210         -5228 (fax)         ontractor or a licensed pump installer. A copy of Part 1 of the		
Telephone No. (bb2) 721-6200 Distance Direction Nearest Town <u>S</u> Miles <u>E</u> of <u>Beneit MS</u>			
Pump Type Circle one         Air Lift       Jet       Submersible         Bucket       Piston       Turbine         Centrifugal       Rotary       Flowing Well         Other (specify):	Power Type Circle one         Diesel Engine       Gasoline Engine       Natural Gas         Electric Motor       Hand       Tractor PTO         Windmill       Other (specify):		
Pump Test Data         Date Well Tested:	Method of Measuring Water Level Circle one         Air Line       Electric Measuring Line       Steel Tape         Other (specify):      i         For flowing well, measured shut in head:      feet         Well yielded      GPM with a drawdown of        feet after      hours of pumping		
I HEREBY CERTIFY that the above statements are true to the best of my knowledge <u>COOK Drilling Give 289</u> Print Name of Pump Installer and License No. (if applicable) Signature of Pump Installer Form: OLWP SWP 48 (04/08) RECEIVED			

۲

٠

JUN 0 2 2009 BY: OLWR

• • · · • • • • • •

and the second s

Ser. 1. 112. 3472.5

13. 19 - ( . 1 . C. )

s i na s ag e sa n in san an in s The shipper t

an the second second

and the second second second second

• • • 

to second se