

DAHOMEY #12
43833
State Well Report

Part 1

Mississippi Department of Environmental Quality
Office of Land and Water Resources
P.O. Box 10631
Jackson, MS 39289-0631
(601)961-5210
(601)354-6938 (fax)

County: BOLIVAR
Permit #: GW-438331
Driller: J. NEWCOME 0.773
Date drilling completed: 5-25-2011

For Office Use Only:
Aquifer: 0153
Well #: _____
L. S. Elevation: _____
E-log #: _____

State Law requires that this report be prepared by the driller in detail and filed with the Department within 30 days of completion of drilling of the well.

Well Owner Information	Well Location
Owner Name: <u>Dahomey Plantation</u>	Latitude: <u>33.41.11</u> " Longitude: <u>90.57.14</u> "
Mailing Address: <u>114 Hickory Creek Circle</u>	Method of Lat/Long (circle one): Conventional Survey
<u>Little Rock AR 72212</u>	USGS quad: <u>Hand-held GPS</u> Survey-grade GPS
City State Zip Code	<u>SE 1/4 NE 1/4</u> Sec <u>07</u> Twn <u>21N</u> Rng <u>07W</u>
Telephone No. () _____	<u>NW NW</u> 08
	Distance Direction Nearest Town
	<u>4.5</u> Miles <u>NE</u> of <u>BENNET</u>

Well Data

Purpose of Well (circle one) Home Industrial Public Supply Irrigation Fish Culture Other: _____

Date well drilling started: 5-25-2011 Date well drilling completed: 5-25-2011

If flowing, method of flow regulation: Valve _____ Other (describe) _____

Static Water Level: _____ feet above or below (circle one) land surface Date measured: _____

Method of Measurement (circle one) steel tape electric tape air line other: _____

Hole depth: 112 Well depth: 110 Well grouted to a depth of 10 feet

Type of grout (circle one): Cement Bentonite Mix

Casing length: 70 feet Casing diameter: 16 inches Type of casing: P.V.C.

Screen length: 40 feet Screen diameter: 16 inches Type of screen: P.V.C.

Screen slot size: .050 inches Setting depth: From 70 feet to 110 feet

Type of completion (circle all applicable): Gravel packed Underreamed Telescoped Open hole Natural Development

Other (describe): _____

Top of lap pipe or reduction in casing: _____ feet. If telescoped or more than one screen, describe on back of page

Logs run (circle all applicable): No log run Electric Gamma Ray Density Sonic Neutron Other: _____

Name of organization running log(s): _____

I certify that the well was drilled, constructed, and completed in accordance with all applicable requirements of the Mississippi Department of Environmental Quality and/or the Mississippi Department of Health regulations and state laws.

JOHN NEWCOME 0.773 _____
Print Name of Water Well Contractor and License No. Signature of Water Well Contractor

RECEIVED
DEC 12 2011
BY: OLWR

County: BOLIVAR
 Permit #: GW-43833
 Driller: J. NEWCOME 0-773
 Date completed: 5-25-2011
Copy information from block on Part 1

STATE WELL REPORT

Part 2

Pump Installer's Completion Report
 Mississippi Department of Environmental Quality
 Office of Land and Water Resources
 P.O. Box 2309
 Jackson, MS 39225
 (601)961-5210
 (601)961-5228 (fax)

For Office Use Only:

Aquifer: _____
 Well #: _____
 Elevation: _____

This part of the report must be completed by a licensed water well contractor or a licensed pump installer. A copy of Part 1 of the report must be attached and both parts filed with the Department at the above address within 30 days of well completion.

Well Owner Information	Well Location
Owner Name: <u>DAHOMEY PLANTATION</u>	Latitude: <u>33°41' 11"</u> Longitude: <u>90°57' 14"</u>
Mailing Address: <u>114 HICKORY CREEK CR.</u>	Method of Lat/Long (check one): Conventional Survey _____
<u>LITTLE ROCK, AR 72212</u>	USGS quad _____, Hand-held GPS <input checked="" type="checkbox"/> , Survey-grade GPS _____
City State Zip Code	<u>SE 1/4 NE 1/4 Sec 07 T 21N R 07W</u>
Telephone No. (____) _____	Distance Direction Nearest Town <u>4.5</u> Miles <u>EAST</u> of <u>BENOIT</u>

Pump Type Circle one	Power Type Circle one
Air Lift <input type="checkbox"/> Jet <input type="checkbox"/> Submersible <input type="checkbox"/>	<input checked="" type="checkbox"/> Diesel Engine <input type="checkbox"/> Gasoline Engine <input type="checkbox"/> Natural Gas
Bucket <input type="checkbox"/> Piston <input type="checkbox"/> <input checked="" type="checkbox"/> Turbine	Electric Motor <input type="checkbox"/> Hand <input type="checkbox"/> Tractor PTO <input type="checkbox"/>
Centrifugal <input type="checkbox"/> Rotary <input type="checkbox"/> Flowing Well <input type="checkbox"/>	Windmill <input type="checkbox"/> Other (specify): _____
Other (specify): _____	Horse Power Rating of Motor: <u>60 HP</u>
Date Pump Installed: <u>5-27-2011</u>	Setting Depth: <u>70</u> feet
Rated Pump Capacity: <u>2400</u> Gallons Per Minute	Number of Stages: <u>1</u>

Pump Test Data	Method of Measuring Water Level Circle one
Date Well Tested: _____	Air Line <input type="checkbox"/> Electric Measuring Line <input type="checkbox"/> Steel Tape <input type="checkbox"/>
Static Water Level (A): _____ Feet Below Land Surface	Other (specify): _____
Pumping Water Level (B): <u>NOT TESTED</u> Feet Below Land Surface	<u>NOT TESTED</u>
Drawdown [(B) - (A)]: _____ Feet Below Land Surface	For flowing well, measured shut in head: _____ feet
Test Pumping Rate: _____ Gallons Per Minute	Well yielded _____ GPM with a drawdown of _____ feet after _____ hours of pumping
Duration of Pump Test (minimum 4 hours): _____ hours	

This is for (circle one): New Well Replacement of Existing Pump Repair of Existing Pump

I HEREBY CERTIFY that the above statements are true to the best of my knowledge.

CORY ROWE 0-711P _____
 Print Name of Pump Installer and License No. (if applicable) Signature of Pump Installer

RECEIVED

DEC 12 2011

BY: OLWR

Form: OLWR-SWR-1C (07-09)



MARIS
Online Maps


Internet Mapping Framework



Map center: 387448, 1432011



This map is a user generated static output from an Internet mapping site and is for general reference only. Data layers that appear on this map may or may not be accurate, current, or otherwise reliable. THIS MAP IS NOT TO BE USED FOR NAVIGATION.

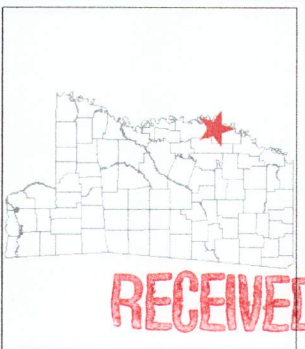

RECEIVED

DEC 12 2011

BY: OLWR

Legend

- County Boundaries
- Township
- Public Land Survey System
- MS One Call Natchez Trace Parkway
- MS One Call Interstate Highway
- MS One Call US / State Highway
- MS One Call 3 digit State Highway
- MS One Call County Roads and Streets
- Incorporated Cities
- Other Urban (non-incorporated)
- NHD Other Areas (dbl streams and Inun)
- adams07_m.sid
- alcorn07_m.sid
- amite07_m.sid
- attala07_m.sid
- benton07
- bolivar07_m.sid
- calhoun07_m.sid
- carroll07_m.sid
- chickasaw07_m.sid
- choctaw07_m.sid
- claborn07_m.sid
- clark07_m.sid



Scale: 1:20,247

