

State Well Report
Part 1 - Driller's Log

Mississippi Department of Environmental Quality
Office of Land and Water Resources
P.O. Box 2309
Jackson, MS 39225
(601) 961-5210
(601) 961-5228 (fax)

For Office Use Only:

Aquifer: Q @ 156
Well #: _____
L.S. Elevation: _____
E-log #: _____

County: Bolivar
Permit #: GW-44925 ✓
Driller: Irrigation Equipment
Date drilling completed: 02/24/2012

State Law requires that this report be prepared by the license holder responsible for the work and filed with the Department at the above address within 30 days of completion of drilling of the well or borehole.

Information on Well Owner (Landowner if borehole is not for a water well)	Well or Borehole Location
Owner Name: <u>Charles Speakes</u>	Latitude: <u>33 ° 38 ' 44 "</u> Longitude: <u>90 ° 57 ' 06 "</u>
Mailing Address: <u>P.O. Box 117</u>	Method of Lat/Long (check one): <input type="checkbox"/> Conventional Survey,
<u>Benoit</u> <u>Ms</u> <u>38725</u>	<input type="checkbox"/> USGS quad, <input checked="" type="checkbox"/> Hand-held GPS, <input type="checkbox"/> Survey-grade GPS
City State Zip code	<u>NW 1/4</u> <u>NW 1/4</u> Sec <u>29</u> ✓ Twn <u>21N</u> Rng <u>7W</u> ✓
Telephone No. () -	Distance Direction Nearest Town
	<u>3 Miles</u> <u>East</u> of <u>Benoit</u>

Well / Borehole Data

Date drilling started: 02/24/2012 Date drilling completed: 02/24/2012 Hole depth: 125 Hole diameter: 18"

Location of the source of any surface water used for drilling: Surface Water

Method of dosing and volume of Chlorine used in drilling and development: 50 PPM

Logs run (check all applicable): No log run Electric Gamma Ray Density Sonic Neutron Other: _____

Name of organization running log(s): _____

Purpose of borehole (check one): Water Well Geotechnical/Geological Investigation Ground Source Heat Pump

Seismic Survey Other (describe) _____

If drilling is not related to water well construction, skip the remainder of this block

Purpose of Well (check one) Home Industrial Public Supply Irrigation Fish Culture Other: _____

If flowing, method of flow regulation: Valve _____ Other (describe) _____

Static Water Level: 37 feet above or below (check one) land surface Date measured: 02/28/2012

Method of Measurement (check one) steel tape electric tape air line other: _____

Well depth: 125 Well grouted to a depth of 10 feet Type of grout (check one): Neat Cement Bentonite Mix

Casing length: 85 feet Casing diameter: 10 inches Type of casing: PVC

Screen length: 40 feet Screen diameter: 10 inches Type of screen: PVC

Screen slot size: .050 inches Setting depth: From 86 feet to 125 feet

Type of completion (check all applicable): Gravel packed Underreamed Telescoped Open hole Natural Development

Other (describe): _____

Top of lap pipe or reduction in casing: _____ feet. *If telescoped or more than one screen, describe on next page*

Form: OLWR-SWR-1A (04/08)

RECEIVED
MAR 09 2012
BY: OLWR

~~0107~~
0156

The sketch below only required for water wells

Description of formations encountered must be provided for all wells and boreholes, unless specifically exempted by regulations

If well telescopes, show depths on sketch.

Ground level	
--------------	--

Description of Formations Encountered	From (depth)	To (depth)
Clay	Ground level	15
Fine Sand	16	45
Medium Sand	46	65
Medium Sand & Gravel	66	75
Course Sand & Gravel	76	121
Clay	122	125

If more than one screen, show location of each on sketch

Sketch the property layout and include the following: 1) the well location; 2) any permanent structures on the property that may aid in locating the well; 3) any roads, power lines, or other items that may aid in locating the property and the well; 4) a north arrow.

Landowner Name: Charles Speakes

Form: OLWR-SWR-1A (04/08)

I certify that the well/borehole was drilled, constructed, and completed in accordance with all applicable requirements of the Mississippi Department of Environmental Quality and the Mississippi Department of Health regulations, if applicable, and state laws.

Patrick Chism/Irrigation Equipment 0695			
<small>Print Name of Responsible Licensee and License No.</small>	<small>Date</small>	<small>Signature of Licensee</small>	RECEIVED

MAR 09 2012
BY: OLWR

STATE WELL REPORT

Part 2

Pump Installer's Completion Report

Mississippi Department of Environmental Quality
Office of Land and Water Resources
P.O. Box 2309
Jackson, MS 39225
(601) 961-5210
(601) 961-5228 (fax)

For Office Use Only:

Aquifer: _____
Well #: Ø156
Elevation: _____

County: Bolivar

Permit #: GW-44925

Driller: Irrigation Equipment

Date drilling completed: 02/24/2012

Copy information from block on Part 1

This part of the report must be completed by a licensed water well contractor or a licensed pump installer. A copy of Part 1 of the report must be attached and both parts filed with the Department at the above address within 30 days of well completion.


Well Owner Information	Well Location
Owner Name: <u>Charles Speakes</u>	Latitude: <u>33 38' 44 N</u> Longitude: <u>90 57' 06 W</u>
Mailing Address: <u>P.O. Box 117</u>	Method of Lat/Long (check one): <input type="checkbox"/> Conventional Survey,
<u>Benoit</u> <u>Ms</u> <u>38725</u>	<input type="checkbox"/> USGS quad, <input checked="" type="checkbox"/> Hand-held GPS, <input type="checkbox"/> Survey-grade GPS
City State Zip code	<u>NW ¼</u> <u>NW ¼</u> Sec <u>29</u> T <u>21N</u> R <u>7W</u>
Telephone No. () - _____	Distance Direction Nearest Town
	<u>3</u> Miles <u>East</u> of <u>Benoit</u>

Pump Type Check one	Power Type Check one
<input type="checkbox"/> Air Lift <input type="checkbox"/> Jet <input checked="" type="checkbox"/> Submersible	<input type="checkbox"/> Diesel Engine <input type="checkbox"/> Gasoline Engine <input type="checkbox"/> Natural Gas
<input type="checkbox"/> Bucket <input type="checkbox"/> Piston <input type="checkbox"/> Turbine	<input checked="" type="checkbox"/> Electric Motor <input type="checkbox"/> Hand <input type="checkbox"/> Tractor PTO
<input type="checkbox"/> Centrifugal <input type="checkbox"/> Rotary <input type="checkbox"/> Flowing Well	<input type="checkbox"/> Windmill <input type="checkbox"/> Other (specify): _____
Other (specify): _____	Horse Power Rating of Motor: <u>30</u>
Date Pump Installed: <u>02/28/2012</u>	Setting Depth: <u>70</u> feet
Rated Pump Capacity <u>1000+/-</u> Gallons Per Minute	Number of Stages: <u>1</u>

Pump Test Data	Method of Measuring Water Level Check one
Date Well Tested: _____	<input type="checkbox"/> Air Line <input type="checkbox"/> Electric Measuring Line <input type="checkbox"/> Steel Tape
Static Water Level (A): _____ Feet Below Land Surface	Other (specify): _____
Pumping Water Level (B): _____ Feet Below Land Surface	
Drawdown [(B) - (A)]: _____ Feet Below Land Surface	For flowing well, measured shut in head: _____ feet
Test Pumping Rate: _____ Gallons Per Minute	Well yielded _____ GPM with a drawdown of _____ feet after _____ hours of pumping
Duration of Pump Test (minimum 4 hours): _____ hours	

This is for (check one): New Well Replacement of Existing Pump Repair of Existing Pump


I HEREBY CERTIFY that the above statements are true to the best of my knowledge.

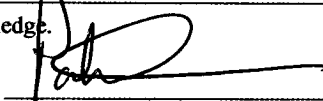Patrick Chism/Irrigation Equipment 0695  **RECEIVED**

Print Name of Pump Installer and License No. (if applicable) Signature of Pump Installer

Form: OLMASW-10 (01/09)
MAR 09 2012

Ø156

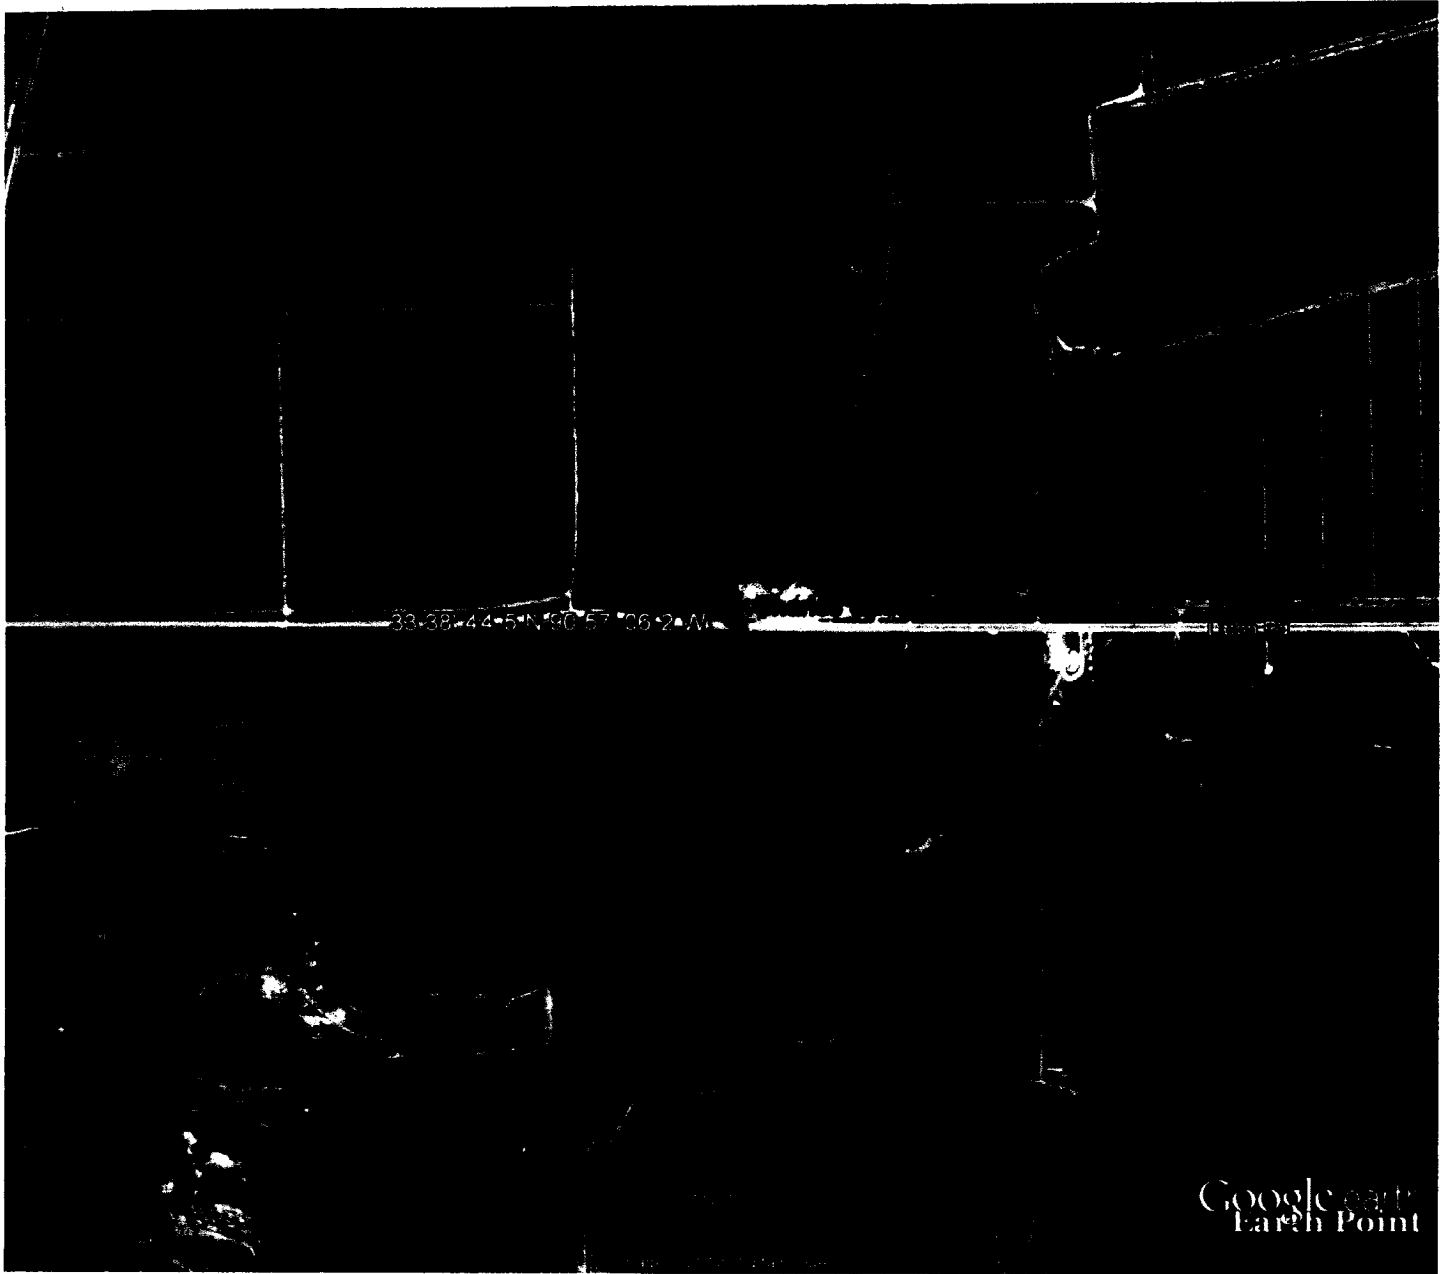

Google earth

feet
km



RECEIVED
MAR 09 2012
BY: OLWR