

STATE WELL REPORT

Part 1

Driller's Log

Mississippi Department of Environmental Quality
Office of Land and Water Resources
P.O. Box 2309
Jackson, MS 39225-2309
(601)961-5210
(601)360-0535 (fax)

For Office Use Only:

Well #: 0168
Aquifer: _____
E-Log #: _____

County: BOLIVAR
Permit #: GW-47915 ✓
Driller: J. NEWCOME 0-773
Date drilling completed: 5-5-14

State Law requires that this report be prepared by the license holder responsible for the work and filed with the Department at the above address within 30 days of completion of drilling of the well or borehole.

Well Owner Information <small>(Landowner if borehole is not for a water well)</small>	Well or Borehole Location
Owner Name: <u>Parkinson Jr, John R, Riley, & Strickland</u>	Latitude: <u>33° 31' 09"</u> Longitude: <u>090° 51' 24"</u>
Mailing Address: <u>P.O. Box 59</u>	Method of Lat/Long (check one): Conventional Survey _____, USGS quad _____, Hand-held GPS <input checked="" type="checkbox"/> , Survey-grade GPS _____
<u>Benoit</u> MS <u>38725</u>	<u>SE 1/4 SE 1/4, Sec 31 T. 21 N R. 07 W</u>
City State Zip Code	<u>4</u> Miles <u>S.E.</u> of <u>BEHOIT</u>
Telephone No. () _____	(Distance) (Direction) (Nearest Town)

Well / Borehole Data

Date drilling started: 5-5-14 Date drilling completed: 5-5-14 Hole depth: 122 Hole diameter: 24"
Location of the source of any surface water used for drilling: SLOUGH
Method of dosing and volume of Chlorine used in drilling and development: CHLORINE TABLETS
Logs run (circle all applicable): No log run Electric Gamma Ray Density Sonic Neutron Other: _____
Name of organization running log(s): _____
Purpose of borehole (circle one): Water Well Geotechnical/Geological Investigation Ground Source Heat Pump
 Seismic Survey Other (describe) _____

If drilling is not related to water well construction, skip the remainder of this block

Purpose of Well (circle all applicable): Home Industrial Public Supply Irrigation Fish Culture
Other (describe): _____
If a flowing well, method of flow regulation: Valve _____ Other (describe) _____
Static Water Level: _____ feet [above or below] land surface Date measured: _____
(circle one)
Method of measurement (circle one): Steel tape Electric tape Air line Other (describe): _____
Well depth: 120 Well grouted to a depth of: 10 feet Type of grout (circle one): Neat Cement Bentonite Mix
Casing length: 80 feet Casing diameter: 16 inches Type of casing: P.V.C.
Screen length: 40 feet Screen diameter: 16 inches Type of screen: P.V.C.
Screen slot size: .050 inches Setting depth: From 80 feet to 120 feet
Type of completion (circle all applicable): Gravel packed Underreamed Open hole Natural Development
Other (describe): _____
Top of lap pipe or reduction in casing: _____ feet

If telescoped or more than one screen, describe on next page

STATE WELL REPORT

Part 2

Pump Installer's Completion Report
 Mississippi Department of Environmental Quality
 Office of Land and Water Resources
 P.O. Box 2309
 Jackson, MS 39225-2309
 (601)961-5210
 (601) 360-0535 (fax)

County: Bolivar
 Permit #: GW-47915
 Driller: J. Newcome O-773
 Date completed: 5-5-14
Copy information from block on Part 1

For Office Use Only:

Well #: 0168
 Aquifer: _____

This part of the report must be completed by a licensed water well contractor or a licensed pump installer. A copy of Part 1 of the report must be attached and both parts filed with the Department at the above address within 30 days of well completion.

Well Owner Information	Well Location
Owner Name: <u>Parkinson Jr, John R, P.R. Ileg & P. Stick</u>	Latitude: <u>33° 57' 09"</u> Longitude: <u>90° 52' 24"</u>
Mailing Address: <u>P.O. Box 59</u>	Method of Lat/Long (check one): Conventional Survey _____, USGS quad _____, Hand-held GPS <input checked="" type="checkbox"/> , Survey-grade GPS _____
<u>Benoit</u> MS <u>38725</u>	<u>SE 1/4 SE 1/4, Sec 31 T.21N R. 07W</u>
City State Zip Code	<u>4</u> Miles <u>S.E.</u> of <u>Benoit</u>
Telephone No. (____) _____	(Distance) (Direction) (Nearest Town)

Pump Type (circle one)

Submersible Turbine Air Lift Centrifugal Flowing Well Jet Piston Rotary Other (describe): _____

Date Pump Installed: 5/7/14 Rated Pump Capacity: 2000 Gallons Per Minute

Is This Pump (circle one): New Repaired Replacement

Power Type (circle one)

Electric Diesel Gasoline Natural Gas Tractor PTO Windmill Other (describe): _____

Horse Power Rating of Motor: 40 Setting Depth: 70 feet Number of Stages: 2

Pump Test Data for Non Flowing Well

Date Well Tested: Not Tested Duration of Pump Test (minimum 4 hours): _____ hours

Static Water Level (A): _____ Feet Below Land Surface Pumping Water Level (B): _____ Feet Below Land Surface

Drawdown [(B) - (A)]: _____ Feet Below Land Surface Test Pumping Rate: _____ Gallons Per Minute

Method of measurement (circle one): Steel tape Electric tape Air line Other (describe): _____

Pump Test Data for Flowing Well

Measured shut in head: _____ feet Not Tested

Well yielded _____ GPM with a drawdown of _____ feet after _____ hours of pumping

Meter Installation

Meter Manufacturer: McCrometer Meter Serial Number: 14-03598

Meter Model Number/Name: M0303 Type of Meter: Propeller

Totalizer Register Unit and Multiplier Factor (AF x .001, gal x 1000, etc): gal x 100

Installation Date: 5/7/14 Meter installed by: Chicot Irrigation

Is This Meter (circle one): New Repaired Replacement


Important: By submitting the above information you are certifying that this meter was installed to manufacturer standards. For agricultural wells, a list of approved meters is on the MDEQ website.

I HEREBY CERTIFY that the above statements are true to the best of my knowledge.

Hubbard Stephens 741-P 5/5/14 Hubbard Stephens

Print Name of Pump Installer and License No. (if applicable) Date Signature of Pump Installer

N33 37 09 W90 57 24 GW-47915

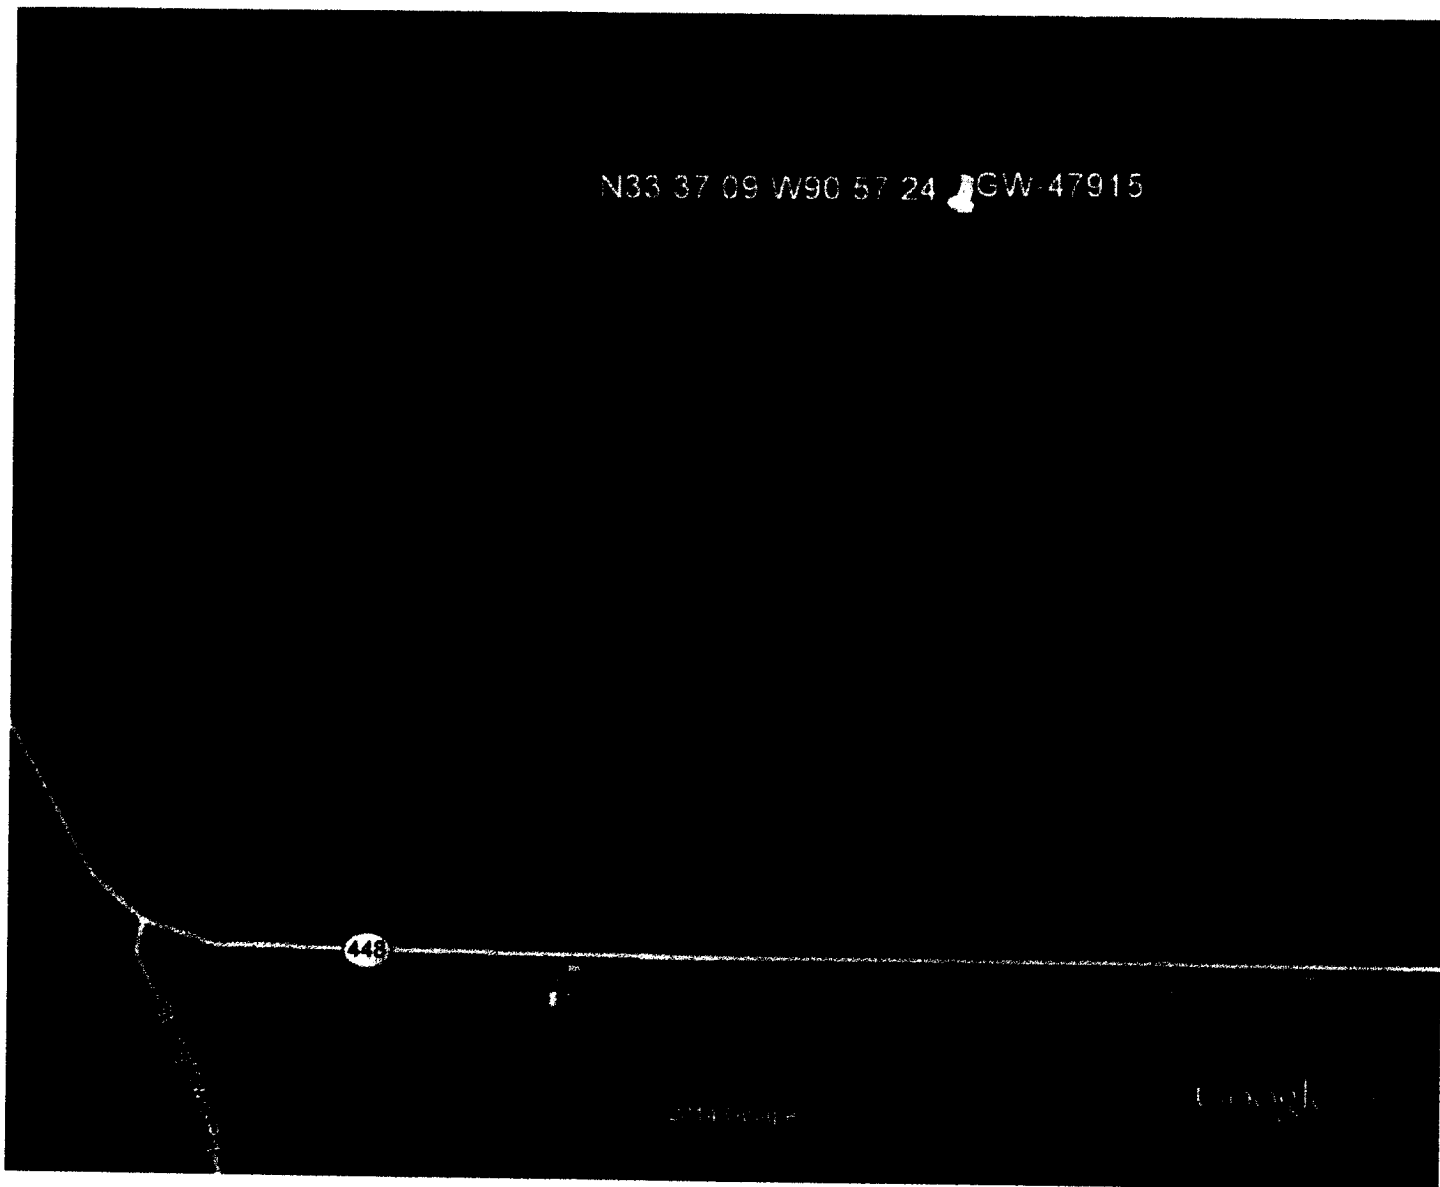

Google earth

