


BOLIVAR MISSISSIPPI BOARD OF WATER COMMISSIONERS
 O -1003
3-12-57 WATER WELL DRILLERS LOG

9/16/65
368

Date: March 12, 1957, Driller: Layne-Central Company County Bolivar
 (Name)

(1) Owner of Land: <u>Dahomey Plantation</u> (Name)	Description & Color of Materials Sand, Clay, Red Clay, Shell, etc.	Thick- ness Feet	Depth Feet
<u>Benoit, Mississippi</u> (Address)	Clay	35	35
(2) Location: <u>1/4, 1/4, Sec. T R</u>	Fine sand	7	42
<u>5</u> miles <u>northeast</u> of <u>Benoit</u> (distance) (direction) (Nearest Town)	Coarse sand	43	85
(3) Topography: <u>flat</u> (Hilly) (Flat) (Level)	Coarse sand & pea gravel	37	122
(4) Purpose of Well: <u>irrigation</u> (Domestic Irrigation Municipal, Industrial, Other)			
Information upon completion of well:			
(1) Diameter <u>16x12</u> inches.			
(2) Total Depth <u>122</u> feet.			
(3) Water Level <u>16' 2"</u> feet below top of ground.			
(4) Cased to <u>58'</u> <u>14'</u> Size <u>12"</u> <u>2'</u> of <u>16" x 12"</u> swage Size <u>16"</u>			
(5) Screen: Size <u>12"</u> , Length <u>50'</u>			
(6) Were any formations sealed against pollution? <u>no</u> yes, <u>no</u> no.			
If YES depth of formation <u>72</u>			
Why _____			
Drillers Remarks: _____			
<u>2232 GPM.</u>			
<u>Electric power.</u>			

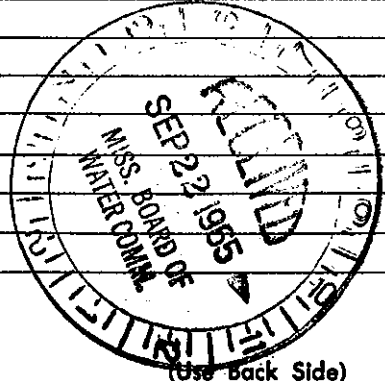

Well No.

Mail this copy to Board of Water Commissioners 429 Miss. St. Jackson, Miss.