

BOLIVAR

MISSISSIPPI BOARD OF WATER COMMISSIONERS

P-53

4-18-65

WATER WELL DRILLERS LOG

Date: 4/18, 1965, Driller: Feltus Walker Supply, County: Bolivar

(1) Owner of Land: J.A. Howarth Jr.
 (Name)
 RFD Cleveland
 (Address) 6, 28 23 6
 (2) Location: 1/4, 1/4, Sec. 2, 3, 4, 17, 20, 21, 22, 23, 24, 25, 26, 27, 28, 29, 30, 31, 32, 33, 34, 35, 36, 37, 38, 39, 40
 3 miles N.W. of Tace
 (distance) (direction) (Nearest Town)
 (3) Topography: (Hilly) (Flat) (Level)
 (4) Purpose of Well: Irrigation
 (Domestic Irrigation, Municipal, Industrial, Other)

Description & Sand, Clay, Red Clay, S	Thick-ness Feet	Depth Feet
Break shot	28	
Fine sand	12	40
Coarse "	30	70
" " gravel	44	114
Bottom Fine sand		

CODED


CODED

Information upon completion of well:

(1) Diameter 16 inches.
 (2) Total Depth 114 feet.
 (3) Water Level 19 feet below top of ground.
 (4) Cased to _____, Size _____
 (5) Screen: Size 16, Length 40
 (6) Were any formations sealed against pollution?
 _____ yes, _____ no.

If YES depth of formation _____
 Why _____

Drillers Remarks: _____
 Yield in G. P. M.: 1400
 Type power: Elec 20HP
 Crops irrigated & Acreage: Rice

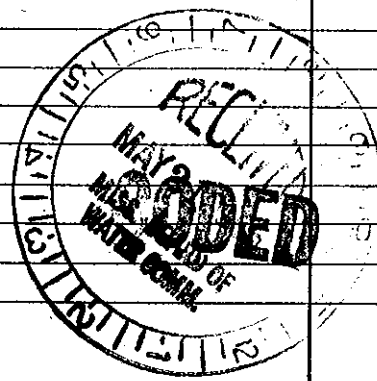

Well No.

(Use Back Side)

Mail this copy to Board of Water Commissioners 429 Miss. St. Jackson, Miss.