

BOLIVAR MISSISSIPPI BOARD OF WATER COMMISSIONERS

P-54

11-4-62

WATER WELL DRILLERS LOG

Bolivar

Date: 11-4, 1962, Driller: ANTONE CAS County LEFLORE

(Name)

(1) Owner of Land: C. T. STANFORD
(Name)
SKENE, MISS
(Address)

(2) Location: 1/4, 1/4, Sec. 3 R6
2 miles WEST of SKENE
(distance) (direction) (Nearest Town)

(3) Topography: FLAT
(Hilly) (Flat) (Level)

(4) Purpose of Well: DOMESTIC
(Domestic Irrigation, Municipal, Industrial, Other)

Description & Color Sand, Clay, Red Clay, Shale, etc.	Thick- ness Feet	Depth Feet
<u>CLAY</u>	<u>15</u>	<u>15</u>
<u>SAND & GRAVEL</u>	<u>135</u>	<u>150</u>
<u>LIGNITE ?</u>	<u>10</u>	<u>160</u>
<u>CLAY</u>	<u>40</u>	<u>200</u>
<u>SAND (WHITE)</u>	<u>40</u>	<u>240</u>
<u>CLAY & SHALE</u>	<u>30</u>	<u>270</u>
<u>SAND</u>	<u>20</u>	<u>290</u>
<u>CLAY</u>	<u>30</u>	<u>320</u>
<u>SAND & CLAY STREAKS</u>	<u>22</u>	<u>342</u>
<u>SAND (WHITE)</u>	<u>13</u>	<u>355</u>

CODED

Information upon completion of well:

(1) Diameter 4 1/2 inches.

(2) Total Depth 355 feet.

(3) Water Level 16 below top of ground.

(4) Cased to 73 Size 7 1/2


(5) Screen: Size 2", Length 20'

(6) Were any formations sealed against pollution?
_____ yes, X no.

If YES depth of formation _____

Why _____

Drillers Remarks: _____

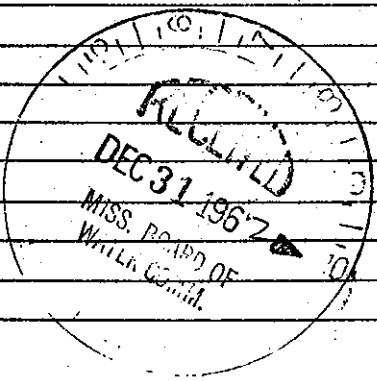

(Use Back Side)

Well No.