

Bolivar
OP56
4-60

MISSISSIPPI BOARD OF WATER COMMISSIONERS


WATER WELL DRILLERS LOG

1/28/66
C 836
CODED

Date: April 16, 1960, Driller: Layne-Central Company County: Bolivar
(Name)

M.B. Litton (1) Owner of Land: <u>Brown Litton &</u> (Name)	Description & Color of Materials Sand, Clay, Red Clay, Shell, etc.	Thick- ness Feet	Depth Feet
<u>Shaw, Mississippi</u> (Address)	Clay	22	22
(2) Location: <u>1/4, 1/4, Sec. 19 T2R6</u>	Medium sand	13	35
<u>5 miles west</u> , of <u>Litton</u> (distance) (direction) (Nearest Town)	Coarse sand	63	98
(3) Topography: <u>flat</u> (Hilly) (Flat) (Level)	Rock		98
(4) Purpose of Well: <u>irrigation</u> (Domestic Irrigation Municipal, Industrial, Other)			
Information upon completion of well:			
(1) Diameter <u>16</u> inches.			
(2) Total Depth <u>98</u> feet.			
(3) Water Level <u>11'1"</u> feet below top of ground.			
(4) Cased to <u>48'</u> , Size <u>16"</u>			
(5) Screen: Size <u>16"</u> , Length <u>50'</u>			
(6) Were any formations sealed against pollution?			
<u>no</u> yes, <u>no</u> no.			
If YES depth of formation _____			
Why _____			
Drillers Remarks: _____			
<u>2400 GPM.</u>			

CODED

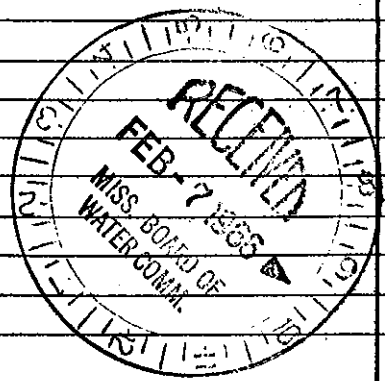

Well No.

(Use Back Side)

Mail this copy to Board of Water Commissioners 429 Miss. St. Jackson, Miss.