

**BOLIAR** MISSISSIPPI BOARD OF WATER COMMISSIONERS

1-4-66  
P61


**WATER WELL DRILLERS LOG**

Date: 1/4, 1966, Driller: BATANE GAS CO OF G. WOOD MEMPHIS  
(Name)

**CODED**

(1) Owner of Land: <u>JOE EARL WATFORD</u> (Name)	Description & Color of Materials Sand, Clay, Red Clay, Shell, etc.	Thick- ness Feet	Depth Feet
<u>R.R. SKENE, MISS.</u> (Address)	<u>0-18 CLAY</u>	<u>18</u>	<u>18</u>
(2) Location: <u>1/4</u> , <u>1/4</u> , Sec. <u>2</u> <u>T2R6</u>	<u>60 SAND + GRAVEL</u>	<u>42</u>	<u>60</u>
<u>2</u> miles <u>SOUTH</u> , of <u>SKENE</u> (distance) (direction) (Nearest Town)	<u>200 PERGRAVEL</u>	<u>180</u>	<u>200</u>
(3) Topography: <u>FLAT</u> (Hilly) (Flat) (Level)	<u>340 CLAY + SHALE</u>	<u>100</u>	<u>340</u>
(4) Purpose of Well: <u>DOMESTIC</u> (Domestic Irrigation Municipal, Industrial, Other)	<u>410 SAND</u>	<u>70</u>	<u>410</u>
Information upon completion of well:	<u>528 SHALE + SAND</u>	<u>118</u>	<u>528</u>
(1) Diameter <u>4" X 2"</u> inches. <u>TOP 126'-4"</u> <u>BOT 666'-2"</u>	<u>658 SHALE + CLAY</u>	<u>130</u>	<u>658</u>
(2) Total Depth <u>692</u> feet.	<u>658-725 SAND</u>	<u>67</u>	<u>725</u>
(3) Water Level <u>32</u> feet below top of ground.	<u>BOTTOM OF WELL</u>		
(4) Cased to <u>126</u> , Size <u>4"</u> <u>126-566-2" PIPE</u>	<u>692 FT</u>		
(5) Screen: Size <u>2"</u> , Length <u>30 FT</u>			
(6) Were any formations sealed against pollution? <u>X</u> yes, <u>X</u> no.			
If YES depth of formation _____			
Why <u>EXTRA DEPTH</u>			
Drillers Remarks: <u>OF SAND + GRAVEL</u>			
Yield in G. P. M.: <u>18</u>			
Type power: <u>ELECTRIC</u>			
Crops irrigated & Acreage: <u>NONE</u>			

**CODED**

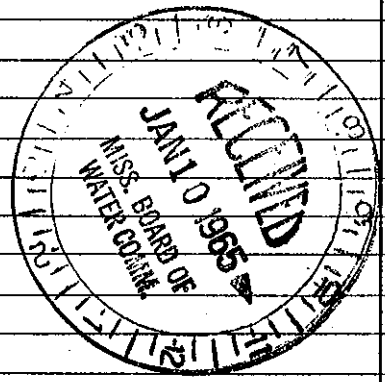

(Use Back Side)

Well No.

Mail this copy to Board of Water Commissioners 429 Miss. St. Jackson, Miss.