

BOARD OF WATER COMMISSIONERS

Bolivar
P62
3-68

WATER WELL DRILLERS LOG

CODED

Date: 3-8, 19 66, Driller: Butane Gas Co of Greenwood County

(Name)

| (1) Owner of Land: <u>A. R. Mann, Jr.</u> (Name) | Description & Color of Materials Sand, Clay, Red Clay, Shell, etc. | Thick- ness Feet | Depth Feet |
|---------------------------------------------------------------------------------------------------------------------------------------|-----------------------------------------------------------------------|------------------------|---------------|
| <u>Skene, Miss.</u> (Address) | Clay | 13 | 13 |
| | Clay | 10 | 23 |
| (2) Location: <u>1/4, 1/4, Sec. 35 22 R 6</u> <u>9</u> miles <u>N.W.</u> , of <u>Shaw</u> (distance) (direction) (Nearest Town) | Coarse Sand | 10 | 33 |
| | Coarse Sand | 10 | 43 |
| (3) Topography: <u>Flat</u> (Hilly) (Flat) (Level) | Coarse Sand | 10 | 53 |
| (4) Purpose of Well: <u>Irrigation</u> (Domestic Irrigation, Municipal, Industrial, Other) | Coarse Sand | 10 | 63 |
| | Coarse Sand | 10 | 73 |
| | Coarse Sand And Gravel | 10 | 83 |
| | Coarse Sand and Gravel | 10 | 93 |
| | Coarse Sand and Gravel | 10 | 103 |
| | Coarse Sand and Gravel | 10 | 113 |

Information upon completion of well:


- (1) Diameter 16 inches.
- (2) Total Depth 106 feet.
- (3) Water Level 20 feet below top of ground.
- (4) Cased to 66, Size 16
- (5) Screen: Size 16, Length 40
- (6) Were any formations sealed against pollution?
 yes, no.

If YES depth of formation _____

Why _____

Drillers Remarks: _____

CODED

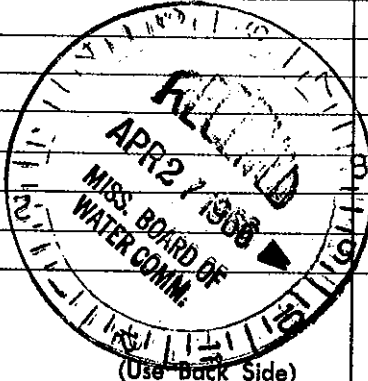

Well No. _____

(Use Back Side)

Retain this copy for your office files.