

**BOLIVAR**  
**P 63**  
**3-8-66**

MISSISSIPPI BOARD OF WATER COMMISSIONERS

**WATER WELL DRILLERS LOG**

Date: March 8, 1966, Driller: Butane Gas Co. of Greenwood County: COLEMAN

(Name)

(1) Owner of Land: McMurray & Webster

(Name)

Shaw, Miss.

(Address)

(2) Location: 1/4, 1/4, Sec 34 35 T21 R6,

4 miles NW of Shaw  
 (distance) (direction) (Nearest Town)

(3) Topography: flat

(Hilly) (Flat) (Level)

(4) Purpose of Well: domestic

(Domestic Irrigation  
 Municipal, Industrial, Other)

Information upon completion of well:

(1) Diameter 4" x 2" inches.

(2) Total Depth 988' feet.

(3) Water Level 17'-11" feet below top of ground.

(4) Cased to 965', Size 4 x 2

(5) Screen: Size 2", Length 20'

(6) Were any formations sealed against pollution?

yes, X no.

If YES depth of formation \_\_\_\_\_

Why \_\_\_\_\_

Drillers Remarks: \_\_\_\_\_


Yield in GPM 18

Type Power Electric

Crops Irrigated: none

| Description & Color of Materials<br>Sand, Clay, Red Clay, Shell, etc. | Thick-<br>ness<br>Feet | Depth<br>Feet |
|---|------------------------|---------------|
| Clay  | 12                     | 12            |
| Sand  | 26                     | 38            |
| Sand & pea gravel   | 94                     | 132           |
| Sand  | 16                     | 148           |
| Rock  | 1                      | 149           |
| Sandy clay  | 69                     | 218           |
| D Sand Shake St.  | 389                    | 607           |
| Gummy shale   | 2                      | 612           |
| H. P. Sand  | 43                     | 655           |
| Gummy shale   | 17                     | 672           |
| D Sand  | 65                     | 737           |
| Gummy shale   | 88                     | 825           |
| Sandy shale   | 81                     | 906           |
| H. P. Sand  | 74                     | 980           |
| Sandy shale   | 8                      | 988           |

**COLEMAN**

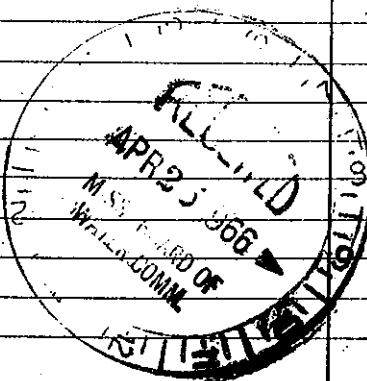

Well No.

(Use Back Side)

Mail this copy to Board of Water Commissioners 429 Miss. St. Jackson, Miss.