

Bolivar
P65

MISSISSIPPI BOARD OF WATER COMMISSIONERS

2-66

WATER WELL DRILLERS LOG

CODED

BUTANE GAS Co

Date: 2-5, 1966, Driller: OF GREENWOOD County ~~Jefferson~~

(Name)

(1) Owner of Land: <u>DAN SELIGMAN</u> (Name)	Description & Color of Materials Sand, Clay, Red Clay, Shell, etc.	Thick- ness Feet	Depth Feet
<u>SHAW, MISS.</u> (Address)	0-10 GUMBO	10	10
	10-20 GUMBO	10	20
(2) Location: <u>1/4, 1/4, Sec. 20 T29R6</u>	20-30 FINE SAND-PEATLICK	10	30
<u>4</u> miles <u>NO. WEST</u> , of <u>SHAW</u> (distance) (direction) (Nearest Town)	30-40 PEAT GRAVEL	10	40
(3) Topography: <u>FLAT</u> (Hilly) (Flat) (Level)	40-50 GRAVEL	10	50
(4) Purpose of Well: <u>IRRIGATION</u> (Domestic Irrigation Municipal, Industrial, Other)	50-60 GRAVEL	10	60
	60-70 GRAVEL	10	70
	70-80 PEAT ROCK-SAND	10	80
	80-90 GRAVEL	10	90
	90-100 GRAVEL	10	100

Information upon completion of well:

- (1) Diameter 16 inches.
- (2) Total Depth 100 feet.
17'5"
- (3) Water Level 17'5" feet below top of ground.
- (4) Cased to 60', Size 16"
- (5) Screen: Size 16", Length 40 FT.
- (6) Were any formations sealed against pollution?
X yes, X no.

If YES depth of formation _____

Why _____


Drillers Remarks: _____

Yield in G. P. M.: 2000

Type power: ELECTRIC

Crops irrigated & Acreage: RICE 165 ac.

CODED

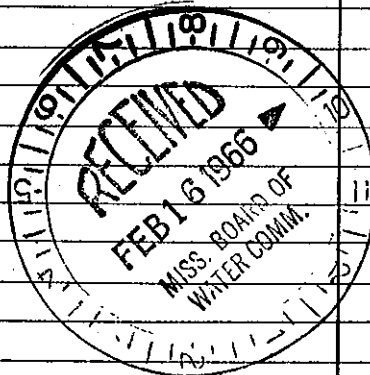

Well No.

(Use Back Side)

Mail this copy to Board of Water Commissioners 429 Miss. St. Jackson, Miss.