

Bolivar
A66

MISSISSIPPI BOARD OF WATER COMMISSIONERS

2-66

WATER WELL DRILLERS LOG

Date: 2-9, 1966, Driller: BITTANE GAS CO OF GREENWOOD

CODED

(Name)

(1) Owner of Land:	Description & Color of Materials Sand, Clay, Red Clay, Shell, etc.	Thick- ness Feet	Depth Feet
<u>DAN SELIGMAN</u> (Name)	0-10 <u>Gravel</u>	10	10
<u>SHAW, MISS.</u> (Address)	10-20 <u>Gravelly Sand</u>	10	20
(2) Location: <u>SE 1/4, SE 1/4, Sec. 21 T28R6</u>	20-30 <u>Fine Sand</u>	10	30
<u>5</u> miles <u>NO. WEST</u> of <u>SHAW</u> (distance) (direction) (Nearest Town)	30-40 <u>SAND + GRAVEL</u>	10	40
(3) Topography: <u>FLAT</u> (Hilly) (Flat) (Level)	40-50 <u>GRAVEL</u>	10	50
(4) Purpose of Well: <u>IRRIGATION</u> (Domestic Irrigation Municipal, Industrial, Other)	50-60 <u>SAND + GRAVEL</u>	10	60
	60-70 <u>GRAVEL</u>	10	70
	70-80 <u>GRAVEL</u>	10	80
	80-90 <u>GRAVEL</u>	10	90
	90-100 <u>GRAVEL</u>	10	100
	100-110 <u>GRAVEL</u>	10	110
	110-114 <u>GRAVEL</u>	4	114

Information upon completion of well:

- (1) Diameter 16 inches.
- (2) Total Depth 111 feet.
- (3) Water Level 15'-9" feet below top of ground.
- (4) Cased to 71 FT, Size 16"
- (5) Screen: Size 16", Length 40 FT
- (6) Were any formations sealed against pollution?
_____ yes, _____ no.

If YES depth of formation _____

Why _____


Drillers Remarks: _____

Yield in G. P. M.: 2500

Type power: ELECTRIC

Crops irrigated & Acreage: RICE 195 AC.

CODED

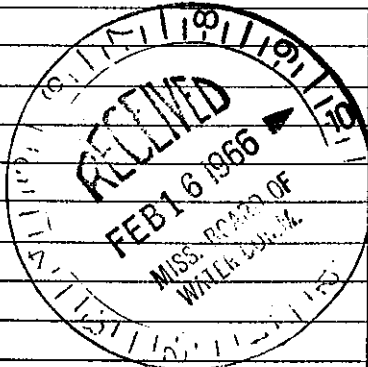

Well No.

(Use Back Side)

Mail this copy to Board of Water Commissioners 429 Miss. St. Jackson, Miss.