

P68

CODED

4-11-62

WATER WELL DRILLERS LOG

Date: 4-11, 1962, Driller: BOTANE GAS CO OF BOLIVAR County: BOLIVAR

(Name)

(1) Owner of Land: A.R. MANN
(Name)
SIKENS, MISS
(Address)

(2) Location: 1/4, 1/4, Sec. 2, 7, 9, 18, 21, 6,
7 miles WEST of SHAW
(distance) (direction) (Nearest Town)

(3) Topography: LEVEL
(Hilly) (Flat) (Level)

(4) Purpose of Well: IRRIGATION
(Domestic Irrigation) (Municipal, Industrial, Other)

Description & Color of Materials Sand, Clay, Red Clay, Shell, etc.	Thick- ness Feet	Depth Feet
BLUE CLAY	25	25
BROWN SAND	9	34
FINE SAND	7	41
COARSE SAND	14	55
C. SAND PER ROCK	32	87
GRAVEL	6	93
PER GRAVEL SAND	13	106
WHITE SAND	8	114

Information upon completion of well:

(1) Diameter 16 inches.

(2) Total Depth 114 feet.

(3) Water Level 11 feet below top of ground.

(4) Cased to 66, Size 16"

(5) Screen: Size 12", Length 48'


(6) Were any formations sealed against pollution?
 _____ yes, X no.

CODED

If YES depth of formation _____

Why _____

Drillers Remarks: _____

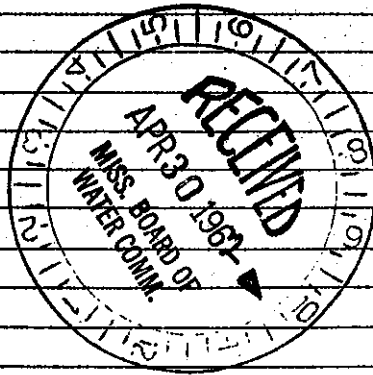

(Use Back Side)

Well No.