

BOLIVAR MISSISSIPPI BOARD OF WATER COMMISSIONERS


P 84
2-12-64

WATER WELL DRILLERS LOG

coded
5/4/64
CODED 2
JM

Date: Feb. 12, 1964, Driller: Layne-Central Company Bolivar
(Name)

(1) Owner of Land: <u>Dan Seligman</u> (Name)	Description & Color of Materials Sand, Clay, Red Clay, Shell, etc.	Thick- ness Feet	Depth Feet
<u>Shaw, Mississippi</u> (Address)	<u>Clay</u>	<u>12</u>	<u>12</u>
(2) Location: <u>1/4, 1/4, Sec. 22 T. 21N. R. 6W.</u>	<u>Coarse sand</u>	<u>44</u>	<u>56</u>
<u>5</u> miles <u>northwest</u> , of <u>Shaw</u> (distance) (direction) (Nearest Town)	<u>Coarse sand, pea gravel</u>	<u>36</u>	<u>92</u>
(3) Topography: <u>flat</u> (Hilly) (Flat) (Level)	<u>Gravel</u>	<u>30</u>	<u>122</u>
(4) Purpose of Well: <u>irrigation</u> (Domestic Irrigation Municipal, Industrial, Other)	CODED		
Information upon completion of well:			
(1) Diameter <u>16</u> inches.			
(2) Total Depth <u>122</u> feet.			
(3) Water Level <u>13'-3"</u> feet below top of ground.			
(4) Cased to <u>62'</u> , Size <u>16"</u> .			
(5) Screen: Size <u>16"</u> , Length <u>60'</u> .			
(6) Were any formations sealed against pollution?			
_____ yes, <u>no</u> no.			
If YES depth of formation _____			
Why _____			
Drillers Remarks: _____			

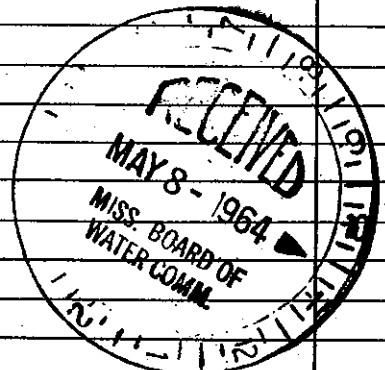

Well No.

(Use Back Side)

Mail this copy to Board of Water Commissioners 429 Miss. St. Jackson, Miss.