

**BOLIVAR** *Change #41 to P 86*  
 MISSISSIPPI BOARD OF WATER COMMISSIONERS

~~P 86~~  
**4-6-62**

**WATER WELL DRILLERS LOG**


*4/18/62*  
**CODED**  
*2*

Date: April 6, 1962, Driller: Layne-Central Company County Bolivar

(Name)

	Description & Color of Materials Sand, Clay, Red Clay, Shell, etc.	Thick- ness Feet	Depth Feet
(1) Owner of Land: <u>Dan Seligman</u> (Name) <u>Shaw, Mississippi</u> (Address)	Clay	18	18
(2) Location: <u>1/4</u> , <u>1/4</u> , Sec. <u>31</u> T21N R6W <u>3</u> miles southwest of <u>Litton</u> (distance) (direction) (Nearest Town)	Fine sand	7	25
(3) Topography: <u>flat</u> (Hilly) (Flat) (Level)	Medium sand	20	45
(4) Purpose of Well: <u>irrigation</u> (Domestic Irrigation Municipal, Industrial, Other)	Coarse sand	20	65
Information upon completion of well:	Coarse sand, pea gravel	27	92
(1) Diameter <u>16</u> inches.	Big gravel	6	98
(2) Total Depth <u>122</u> feet.	Pea gravel	24	122
(3) Water Level <u>16' - 7"</u> feet below top of ground.			
(4) Cased to <u>62'</u> , Size <u>16"</u>			
(5) Screen: Size <u>16"</u> , Length <u>60'</u>			
(6) Were any formations sealed against pollution? <u>no</u> yes, <u>no</u> no.			
If YES depth of formation _____			
Why _____			
Drillers Remarks: _____			
_____			
_____			
**CODED**

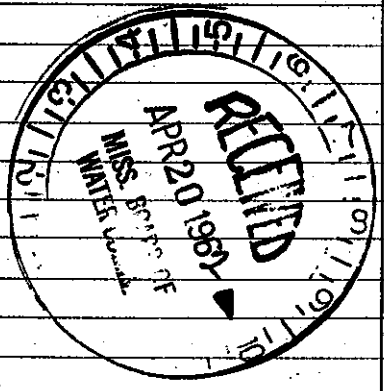

Well No.

(Use Back Side)

Mail this copy to Board of Water Commissioners 429 Miss. St. Jackson, Miss.