

Bolivar
 P 92
 70-67

MISSISSIPPI
 BOARD OF WATER COMMISSIONERS
 416 North State Street
 Jackson, Mississippi 39201

COLED

WATER WELL DRILLERS LOG

July 21 1967 Dyer Well & Irr. Ser. Bolivar
 date well completed firm name county well located

LANDOWNER: W. H. Howarth Jr.
 R. R. 2 Cleveland, Miss.
 (mailing address)

description of formations encountered	from	to
Clay	0	13
Clay	13	23
Fine brown sand	23	53
Coarse sand	53	63
Coarse sand & gravel	63	103

WELL LOCATION:
 sec. 20 T. 21 N. R. 6 W.
 4 miles SW of SKENE
 (distance) (direction) (nearest town)

WELL PURPOSE: Irrigation (rice)
 (home, irrigation, municipal, industrial)

WELL COMPLETION DATA:

(1) diameter (inches) 12"

(2) total depth (feet) 103'

(3) static water level (feet) 18' below top of ground.


(4) casing 12 Blk. 63'
 (material) (depth)
 (size) If telescope see back.

(5) screen 40' 63'
 (length) (depth to top)
 12" Black Ingot Iron
 (size) (material)

(6) pump 28 1500
 (HP) (yield gpm)
 Diesel
 (type power)

(7) electric log No
 (yes or no)
 (organization running log)

(8) how well bottom plugged
 Steel Plate Welded on

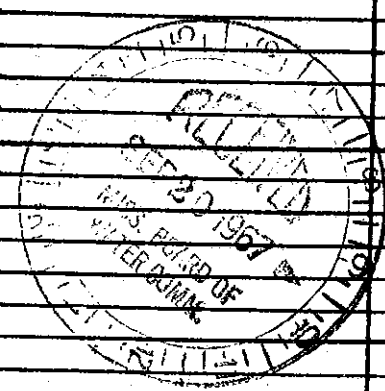

DRILLERS REMARKS: