

Bolivar
P 93
2/68

MISSISSIPPI
BOARD OF WATER COMMISSIONERS
416 North State Street
Jackson, Mississippi 39201

WATER WELL DRILLERS LOG

FEB 14 1968 Dyer Well Dr. Bolivar
date well completed firm name county well located

LANDOWNER: W. H. HOWARTH
R. R.
SKENE, MISS.
(mailing address)

WELL LOCATION:
sec. 8 T. 21 N. R. 6 E
4 miles S.W. of SKENE
(distance) (direction) (nearest town)


WELL PURPOSE: IRRIGATION
(home, irrigation, municipal, industrial)

WELL COMPLETION DATA:

- (1) diameter (inches) 16"
- (2) total depth (feet) 105'
- (3) static water level (feet) 18' below top of ground.
- (4) casing (material) IRON (depth) 63'
- (size) if telescope see back.
- (5) screen 40' 63' (length) (depth to top)
10" (size) (material) BRK 1 1/2" DIA
- (6) pump 50 (HP) 2500 (yield gpm)
ELEC (type power)
- (7) electric log NO (yes or no)
- (organization running log) PLATO ON BOTTOM
- (8) how well bottom plugged

description of formations encountered	from to	
CLAY	0	13
MED. SAND	13	23
MED. SAND + GRAVEL	23	33
FINE SAND	33	43
MED. SAND	43	63
COARSE SAND + GRAVEL	63	103

COPIED

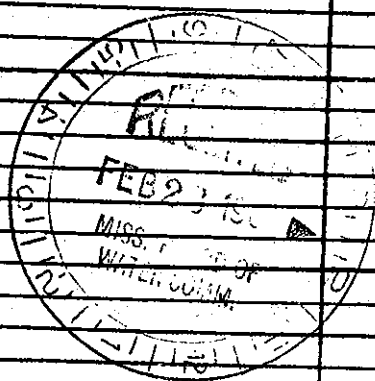

DRILLERS REMARKS: