

Bolivar  
P115  
1/14/81

MISSISSIPPI DEPARTMENT OF NATURAL RESOURCES  
Bureau of Land and Water Resources  
Southport Mall  
P.O. Box 10631 0005  
Jackson, Mississippi 39209  
WATER WELL DRILLERS LOG


1/14 1981 date well completed  
Dyer firm name  
Bolivar county well located

LANDOWNER:  
BIG D  
TOPANGA FARMS  
Blaine (mailing address) MS.  
WELL LOCATION:  
sec. 26-T 40 N R. 6 E S 7 W  
2 miles NW of Shaw  
(distance) (direction) (nearest town)

description of formations encountered	from	to
Clay	0	20
fine sand	20	38
sand	38	48
sand & gravel	48	111

WELL PURPOSE:  
(home, irrigation, municipal, industrial)

- WELL COMPLETION DATA:
- (1) diameter (inches) 16"
  - (2) total depth (feet) 111'
  - (3) static water level (feet) 23' below top of ground.
  - (4) casing Steel 111' (material) (depth)  
16" (size) If telescope see back.
  - (5) screen 40' 71' (length) (depth to top)  
16" (size) Steel (material)
  - (6) pump 80 (HP) 1200 (yield gpm)  
Pneum (type power)
  - (7) electric log (yes or no)
  - (organization running log)
  - (8) how well bottom plugged plate

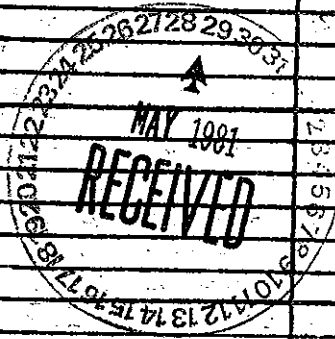

DRILLERS REMARKS: