

BOLIVAR
P 117
3-4-81

MISSISSIPPI DEPARTMENT OF NATURAL RESOURCES
 Bureau of Land and Water Resources
 Southport Mall
 P.O. Box 10631
 Jackson, Mississippi 39209
WATER WELL DRILLERS LOG

INDEXED

3/4 19 81 Dyer Bolivar
 date well completed firm name county well located

LANDOWNER:
AVRITT FARMS
 (mailing address)


WELL LOCATION:
 sec. 32 NE R. 6 E.
4.5 miles N-W of Shaw
 (distance) (direction) (nearest town)

WELL PURPOSE:
 (home, irrigation, municipal, industrial)

WELL COMPLETION DATA:
 (1) diameter (inches) 12"
 (2) total depth (feet) 103'
 (3) static water level (feet) 23' below above top of ground.
 (4) casing Steel 103'
 (material) (depth)
 12" If telescope see back.
 (size)
 (5) screen 40' 63'
 (length) (depth to top)
 12" Steel
 (size) (material)
 (6) pump 30 1200
 (HP) (yield gpm)
 Propane
 (type power)
 (7) electric log (yes or no)
 (organization running log)
 (8) how well bottom plugged plate

description of formations encountered	from	to
clay	23	33
ssm	33	43
ssm	43	53
ssm + gravel	53	63
ssm + gravel	63	73
gravel	73	83
gravel	83	93
gravel	93	103

INDEXED

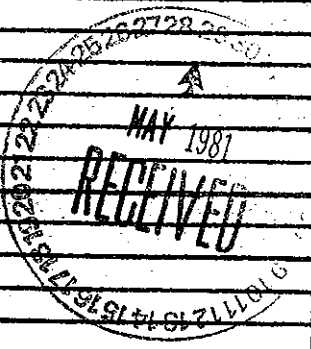

DRILLERS REMARKS: