


If well telescopes, please sketch and show depths.

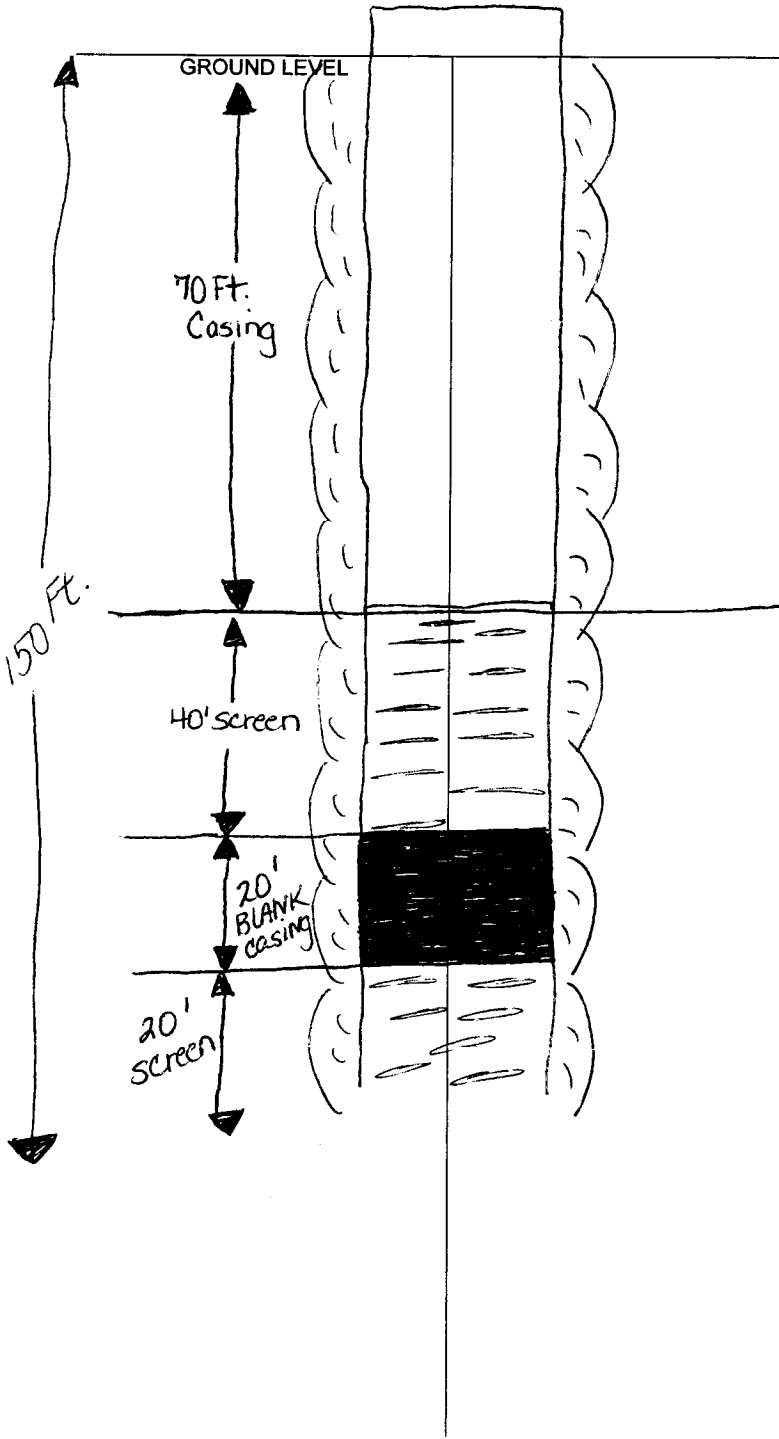

If more than one screen, show location of each on sketch.

SECTION _____

Please indicate well location X.

Pump Capacity (GPM) 2500	No. of Stages 1	Setting Depth 70 FT.
------------------------------------	---------------------------	--------------------------------

PUMP TEST

Well yielded NOT TESTED GPM with a drawdown of _____ ft. after _____ hours of pumping

LOG DATA

TYPE OF LOG RUN (Check One): No Log Run
 Electric, Gamma Ray, Density, Sonic, Neutron,
 Other (Describe) _____

Name of Organization Running Log _____

GEOLOGICAL DATA (Office Use Only)

Surface Elev.	Geologic Unit	Unit Thickness	Depth to Top
Subs SWL	Date	Analysis	Aquifer Test

Driller's Remarks
