	State Well Report	
County: BOLIVAR OIL	Part 1	For Office Use Only:
Permit #:	Mississippi Department of Environmental	
	Office of Land and Water Resource P.O. Box 10631	well #: <b>P-167</b>
Driller: SLANEY COOK.	Jackson, MS 39289-0631	L. S. Elevation:
Date drilling completed: 3/26/04	(601)961-5210	
. / (	(601)354-6938 (fax)	E-log #:
State Law requires that this rep	ort be prepared by the driller in detail an	d filed with the Department within
Jo days of completion of drinin	or the well.	
Well Owner Inform	ition	Well Location
Owner Name GUDE CARV	Latitude: N33° 3	6:999 " Longitude / /8° 47:6
Mailing Address: 1560 Hwy	,1,10	6:999 " Longitude(1/96° 47; 6
Mailing Address: 7560 Hwy	<u> </u>	g (circle one): Conventional Survey,
	USGS quad, 1	Hand-held GPS, Survey-grade GPS
~		Hand-held GPS, Survey-grade GPS Sec <u>35</u> Twn <u>21 N</u> Rng 610
City St	5 30/13	
City St	te Zip Code Distance D	$\frac{\text{Nearest Town}}{NE} \text{ of } SHAW MS}$
Telephone No. ()		VE " SHHW, NS
	Well Data	
Purpose of Well (circle one) Home In	ustrial Public Supply Irrigation Fish C	Culture Other:
Date well drilling started:	6/05 Date well drilling completed	
If flowing, method of flow regulation: Va	(1 - 1)	- /
it no mile, momoe or non regulation.	Ve Other (describe)	
Static Water Level:feet a	ove or velow circle one) land surface Date n	neasured: <u>3/26/05</u>
	ove or velow circle one) land surface Date n	
Static Water Level: <u>28</u> feet a Method of Measurement (circle one)	ove or velow circle one) land surface Date n	neasured: <u>3/26/05</u> ner:
Static Water Level: <u>28</u> feet a Method of Measurement (circle one) $\frac{1}{20}$ Hole depth: <u>/20</u> Well de	ove or colow (circle one) land surface Date n cel tape electric tape air line oth th: $120^{1}$ Well grouted to a d	neasured: <u>3/26/05</u> ner:
Static Water Level: <u>28</u> feet a Method of Measurement (circle one) Hole depth: <u>/20</u> Well de Type of grout (circle one): Cement	ove or below (circle one) land surface Date n bel tape electric tape air line oth th: Well grouted to a d Bentonite Mix	heasured: $3/26/05$ her: lepth offeet
Static Water Level: <u>28</u> feet a Method of Measurement (circle one) $\frac{1}{20}$ Hole depth: <u>/20</u> Well de	ove or below (circle one) land surface Date n bel tape electric tape air line oth th: Well grouted to a d Bentonite Mix	heasured: $3/26/05$ her: lepth offeet
Static Water Level: <u>28</u> feet a Method of Measurement (circle one) Hole depth: <u>/20</u> Well de Type of grout (circle one): Cement Casing length: <u>80</u> feet Cas	ove or below (circle one) land surface Date n bel tape electric tape air line oth oth:20' Well grouted to a d Bentonite Mix ng diameter: (	heasured: $3/26/0.5$ her: hepth offeet casing:
Static Water Level: <u>28</u> feet a Method of Measurement (circle one) Hole depth: <u>/20</u> Well de Type of grout (circle one): Cement Casing length: <u>80</u> feet Cas Screen length: <u>40</u> feet Scr	ove or below (circle one) land surface Date n bel tape electric tape air line oth th:20' Well grouted to a d Bentonite Mix ng diameter:6 inches Type of en diameter:6 inches Type of	neasured: $3/26/0.5$ ner: lepth offeet casing: screen: casing:
Static Water Level: <u>28</u> feet a Method of Measurement (circle one) Hole depth: <u>/20</u> Well de Type of grout (circle one): Cement Casing length: <u>80</u> feet Cas	ove or below (circle one) land surface Date n bel tape electric tape air line oth th:20 ' Well grouted to a d Bentonite Mix ng diameter:6_inches Type of en diameter:6_inches Type of	heasured: $3/26/0.5$ her: hepth offeet casing:
Static Water Level: <u>28</u> feet a Method of Measurement (circle one) Hole depth: <u>/20</u> Well de Type of grout (circle one): Cement Casing length: <u>80</u> feet Cas Screen length: <u>40</u> feet Scr	ove or below (circle one) land surface Date n bel tape electric tape air line oth th:20' Well grouted to a d Bentonite Mix ng diameter:6_inches Type of en diameter:6_inches Type of Setting depth: Fromfeet	neasured: $3/26/0.5$ ner: lepth offeet casing: screen: casing:
Static Water Level: <u>28</u> feet a Method of Measurement (circle one) Hole depth: <u>/20</u> Well de Type of grout (circle one): Cement Casing length: <u>80</u> feet Cas Screen length: <u>40</u> feet Scr Screen slot size: <u>.050</u> inches	ove or below (bircle one) land surface Date n bel tape electric tape air line oth th:20' Well grouted to a d Bentonite Mix ng diameter:6_inches Type of en diameter:6_inches Type of Setting depth: Fromfeet Gravel packed Underreamed Telescoped	neasured: $3/26/0.5$ ner: lepth offeet casing: $PVC$ screen: $PVC$ to20 feet d Open hole Natural Development
Static Water Level: <u>28</u> feet a Method of Measurement (circle one) Hole depth: <u>/20</u> Well de Type of grout (circle one): Cement Casing length: <u>80</u> feet Cas Screen length: <u>40</u> feet Scr Screen slot size: <u>.050</u> inches	ove or below (circle one) land surface Date n bel tape electric tape air line oth th:20' Well grouted to a d Bentonite Mix ng diameter:6_inches Type of en diameter:6_inches Type of Setting depth: Fromfeet	neasured: $3/26/0.5$ ner: lepth offeet casing: $PVC$ screen: $PVC$ to20 feet d Open hole Natural Development
Static Water Level: <u>28</u> feet a Method of Measurement (circle one) Hole depth: <u>/20</u> Well de Type of grout (circle one): Cement Casing length: <u>80</u> feet Cas Screen length: <u>40</u> feet Scr Screen slot size: <u>.050</u> inches	ove or below (bircle one) land surface Date n bel tape electric tape air line oth th:20' Well grouted to a d Bentonite Mix ng diameter:6_ inches Type of en diameter:6_ inches Type of Setting depth: Fromfeet Gravel packed Underreamed Telescoped Other (describe):	neasured: $3/26/0.5$ ner: lepth offeet casing: $PVC$ screen: $PVC$ to20 feet d Open hole Natural Development
Static Water Level: <u>28</u> feet a Method of Measurement (circle one) Hole depth: <u>/20</u> Well de Type of grout (circle one): Cement Casing length: <u>80</u> feet Cas Screen length: <u>40</u> feet Scr Screen slot size: <u><math>050</math></u> inches Type of completion (circle all applicable)	ove or velow (circle one) land surface Date n vel tape electric tape air line oth th: Well grouted to a d Bentonite Mix ng diameter: ( inches Type of en diameter: ( inches Type of Setting depth: From feet Gravel packed Underreamed Telescoped Other (describe): feet. If telescoped or more that	neasured: $3/26/05$ ner: lepth of feet casing: $PVC$ screen: $PVC$ to feet d Open hole Natural Development n one screen, describe on back of page
Static Water Level:	ove or below (bircle one) land surface Date n bel tape electric tape air line oth th:20' Well grouted to a d Bentonite Mix ng diameter:6_ inches Type of en diameter:6_ inches Type of Setting depth: Fromfeet Gravel packed Underreamed Telescoped Other (describe):	neasured: $3/26/05$ ner: lepth of feet casing: $PVC$ screen: $PVC$ to feet d Open hole Natural Development n one screen, describe on back of page
Static Water Level: <u>28</u> feet a Method of Measurement (circle one) <u>3</u> Hole depth: <u>120</u> Well de Type of grout (circle one): Cement Casing length: <u>80</u> feet Cas Screen length: <u>40</u> feet Scr Screen slot size: <u>050</u> inches Type of completion (circle all applicable) Top of lap pipe or reduction in casing: Logs run (circle all applicable). <u>No log-rr</u> Name of organization running log(s):	ove or kelow (circle one) land surface Date n kel tape electric tape air line oth th: Well grouted to a d Bentonite Mix ng diameter: ( inches Type of en diameter: ( inches Type of Setting depth: From feet Gravel packed Underreamed Telescoped Other (describe): feet. If telescoped or more tha Electric Gamma Ray Density Sonic N	neasured: $3/26/05$ ner: lepth of feet casing: $PVC$ screen: $PVC$ to feet d Open hole Natural Development n one screen, describe on back of page leutron Other:
Static Water Level: $28$ feet a Method of Measurement (circle one) $3$ Hole depth: $120$ Well de Type of grout (circle one): Cement Casing length: $80$ feet Cas Screen length: $40$ feet Scr Screen slot size: $050$ inches Type of completion (circle all applicable) Top of lap pipe or reduction in casing: Logs run (circle all applicable): No log-rr Name of organization running log(s): I certify that the well was drilled, const	ove or below (bircle one) land surface Date n bel tape electric tape air line off th:	neasured: $3/26/0.5$ ner: lepth of feet casing: $PVC$ screen: $PVC$ to $/2.0$ feet d Open hole Natural Development n one screen, describe on back of page leutron Other: pplicable requirements of the Mississi
Static Water Level: $28$ feet a Method of Measurement (circle one) $3$ Hole depth: $120$ Well de Type of grout (circle one): Cement Casing length: $80$ feet Cas Screen length: $40$ feet Scr Screen slot size: $050$ inches Type of completion (circle all applicable) Top of lap pipe or reduction in casing: Logs run (circle all applicable): No log-run Name of organization running log(s): I certify that the well was drilled, const	ove or kelow (circle one) land surface Date n kel tape electric tape air line oth th: Well grouted to a d Bentonite Mix ng diameter: ( inches Type of en diameter: ( inches Type of Setting depth: From feet Gravel packed Underreamed Telescoped Other (describe): feet. If telescoped or more tha Electric Gamma Ray Density Sonic N	neasured: $3/26/0.5$ ner: lepth of feet casing: $PVC$ screen: $PVC$ to $/2.0$ feet d Open hole Natural Development n one screen, describe on back of page leutron Other: pplicable requirements of the Mississi
Static Water Level:	ove or below (bircle one) land surface Date n bel tape electric tape air line off th:	neasured: $3/26/0.5$ ner: lepth of feet casing: $PVC$ screen: $PVC$ to $/2.0$ feet d Open hole Natural Development n one screen, describe on back of page leutron Other: pplicable requirements of the Mississi
Static Water Level: $28$ feet a Method of Measurement (circle one) $3$ Hole depth: $120$ Well de Type of grout (circle one): Cement Casing length: $80$ feet Cas Screen length: $40$ feet Scr Screen slot size: $050$ inches Type of completion (circle all applicable) Top of lap pipe or reduction in casing: Logs run (circle all applicable): No log-run Name of organization running log(s): I certify that the well was drilled, const	ove or below (bircle one) land surface Date n bel tape electric tape air line off th:20' Well grouted to a d Bentonite Mix ng diameter:6 inches Type of en diameter:6 inches Type of Setting depth: From6 feet Gravel packed Underreamed Telescoped Other (describe): feet. If telescoped or more that Electric Gamma Ray Density Sonic N ucted, and completed in accordance with all a	neasured: $3/26/0.5$ ner: lepth of feet casing: $PVC$ screen: $PVC$ to $/2.0$ feet d Open hole Natural Development n one screen, describe on back of page leutron Other: pplicable requirements of the Mississi
Static Water Level: $28$ feet a Method of Measurement (circle one) $3$ Hole depth: $120$ Well de Type of grout (circle one): Cement Casing length: $80$ feet Cas Screen length: $40$ feet Scr Screen slot size: $050$ inches Type of completion (circle all applicable) Top of lap pipe or reduction in casing: Logs run (circle all applicable): No log-run Name of organization running log(s): I certify that the well was drilled, const	ove or below (bircle one) land surface Date n bel tape electric tape air line off with:	neasured: $3/26/0.5$ ner: lepth of feet casing: $PVC$ screen: $PVC$ to $/2.0$ feet d Open hole Natural Development n one screen, describe on back of page leutron Other: pplicable requirements of the Mississi
Static Water Level: $28$ feet a Method of Measurement (circle one) Hole depth: $120$ Well de Type of grout (circle one): Cement Casing length: $80$ feet Cas Screen length: $40$ feet Scr Screen slot size: $050$ inches Type of completion (circle all applicable) Top of lap pipe or reduction in casing: Logs run (circle all applicable): No log run Name of organization running log(s): I certify that the well was drilled, const Department of Environmental Quality	ove or below (bircle one) land surface Date n bel tape electric tape air line off with:	neasured: $3/26/0.5$ ner: lepth of feet casing: $PVC$ screen: $PVC$ to $ ZO$ feet d Open hole Natural Development n one screen, describe on back of page leutron Other: pplicable requirements of the Mississi egulations and state laws.

`

BY: OLWR


If well telescopes please sketch below and show depths.

Ground Level

٦.

Description of Formations Encountered	From	<u>1 To</u>
Clay	0	5
Sand	54	6
Heavy Sand and Gravel	66	
		<u> </u>
······································		
		+
		+
		+
		-
		+
		$\top$
		_
		-
· · · · · · · · · · · · · · · · · · ·		+-
		+
		-

If more than one screen, show location of each on sketch

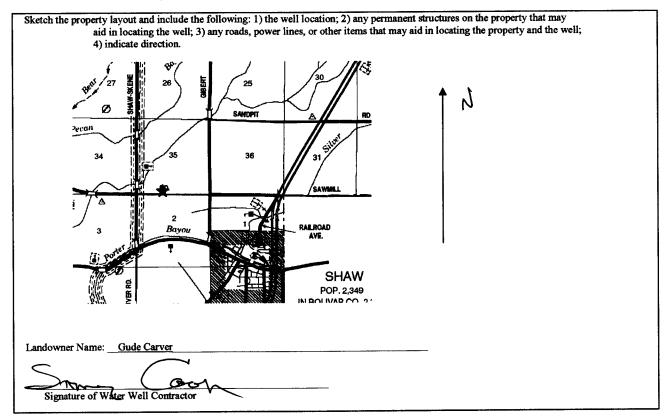

RECEIVED APR 2.6 2005 BY: OLWR

STATE W	ELL REPORT		
County: Description   Permit #: Pump Installer   Driller 10 Neu   Dook Jackson,   Date completed: 3/22/25	Part 2 r's Completion Report ent of Environmental Quality d and Water Resources . Box 10631 MS 39289-0631 1)961-5210 354-6938 (fax) For Office Use Only: Aquifer: Well #: Elevation:		
This report should be prepared by the pump installer in de installation of pump.	tail and filed with the Department within 30 days of the		
Well Owner Information	Well Location		
Owner Name: GUOL CARVER	Latitude: <u>N 33°36.989</u> Longitude: <u>W 90° 47. 64</u> 0'		
Mailing Address: 1560 Hwy 448	Method of Lat/Long (circle one): Conventional Survey,		
	USGS quad, Haud-held GPS, Survey-grade GPS		
SHAW MS 38773 City State Zip Code	<u>SE</u> <sup>1</sup> / <sub>4</sub> <u>Sw</u> <sup>1</sup> / <sub>4</sub> Sec <u>35</u> Twn <u>21N</u> Rng <u>6</u> W Distance Direction Nearest Town		
Telephone No. ()	Y2 Miles DE of SHAW, MS		
Pump Type Circle one	Power Type Circle one		
Air Lift Jet Submersible	Diesel Engine Gasoline Engine Natural Gas		
Bucket Piston Turbine	Electric Motor Hand Tractor PTO		
Centrifugal Rotary Flowing Well	Windmill Other (specify):		
Other (specify):	Horse Power Rating of Motor: 60 HP		
Date Pump Installed:4/21/05	Setting Depth: 70 feet		
Rated Pump Capacity:Gallons Per Minute	Number of Stages:		
Pump Test Data	Method of Measuring Water Level Circle one		
Date Well Tested:	Air Line Electric Measuring Line Steel Tape		
Static Water Level (A): 28 Feet Below Land Surface	Other (specify):		
Pumping Water Level (B):Feet Below Land Surface			
Drawdown [(B) – (A)]:Feet Below Land Surface	For flowing well, measured shut in head:feet		
Test Pumping Rate:Gallons Per Minute	Well yielded GPM with a drawdown of		
Duration of Pump Test (minimum 4 hours):hours	feet afterhours of pumping		
I HEREBY CERTIFY that the above statements are true to the best $M_{A77} \\ S_{743} \\ \hline \\ $	t of my knowledge. Math Support Signature of Pump Installer		

APR 2 6 2005 BY: OLWR