

# State Well Report

## Part 1

Mississippi Department of Environmental Quality  
Office of Land and Water Resources  
P.O. Box 10631  
Jackson, MS 39289-0631  
(601)961-5210  
(601)354-6938 (fax)

County: Bolivar  
Permit #: 60042651  
Irrigation Equipment  
Driller: \_\_\_\_\_  
Date drilling completed: 6-24-08

For Office Use Only:  
Aquifer: \_\_\_\_\_  
Well #: P-180  
L. S. Elevation: \_\_\_\_\_  
E-log #: \_\_\_\_\_

State Law requires that this report be prepared by the driller in detail and filed with the Department within 30 days of completion of drilling of the well.

Well Owner Information	Well Location
Owner Name: <u>Morgan Planting</u>	Latitude: <u>33° 37' 40.7"</u> Longitude: <u>90° 51' 01.7"</u>
Mailing Address: <u>2612 Hwy 448</u>	Method of Lat/Long (circle one): <u>25</u> Conventional Survey, <u>02</u>
<u>Shaw</u> <u>Ms.</u> <u>38773</u>	USGS quad, Hand-held GPS, Survey-grade GPS
City State Zip Code	<u>NW 1/4 SW 1/4 Sec 32 Twn 21N Rng 6W</u>
Telephone No. ( ) _____	Distance Direction Nearest Town <u>4</u> Miles <u>W</u> of <u>Shaw</u>

**Well Data**

Purpose of Well (circle one) Home Industrial Public Supply Irrigation Fish Culture Other: \_\_\_\_\_

Date well drilling started: 6-24-08 Date well drilling completed: 6-24-08

If flowing, method of flow regulation: Valve \_\_\_\_\_ Other (describe) \_\_\_\_\_

Static Water Level: 40 feet above of below (circle one) land surface Date measured: 6-26-08

Method of Measurement (circle one) steel tape electric tape air line other: \_\_\_\_\_

Hole depth: 136 Well depth: 136 Well grouted to a depth of 10 feet

Type of grout (circle one): Cement Bentonite Mix

Casing length: 86 feet Casing diameter: 16 inches Type of casing: PVC

Screen length: 50 feet Screen diameter: 16 inches Type of screen: PVC

Screen slot size: .050 inches Setting depth: From 87 feet to 136 feet

Type of completion (circle all applicable): Gravel packed Underreamed Telescoped Open hole Natural Development

Other (describe): \_\_\_\_\_

Top of lap pipe or reduction in casing: \_\_\_\_\_ feet. If telescoped or more than one screen, describe on back of page

Logs run (circle all applicable) No log run Electric Gamma Ray Density Sonic Neutron Other: \_\_\_\_\_

Name of organization running log(s): \_\_\_\_\_

I certify that the well was drilled, constructed, and completed in accordance with all applicable requirements of the Mississippi Department of Environmental Quality and/or the Mississippi Department of Health regulations and state laws.

Irrigation Equipment Inc  
Patrick M. Chism 0695

Print Name of Water Well Contractor and License No. \_\_\_\_\_ Signature of Water Well Contractor: [Signature]

RECEIVED  
JUL 09 2008  
BY: OLWR



# STATE WELL REPORT

## Part 2

**Pump Installer's Completion Report**  
 Mississippi Department of Environmental Quality  
 Office of Land and Water Resources  
 P.O. Box 10631  
 Jackson, MS 39289-0631  
 (601)961-5210  
 (601)354-6938 (fax)

County: Bolivar  
 Permit #: 2004/2651  
**Irrigation Equipment**  
 Driller: \_\_\_\_\_  
 Date completed: 6-24-08

For Office Use Only:

Aquifer: \_\_\_\_\_  
 Well #: P-180  
 Elevation: \_\_\_\_\_

This report should be prepared by the pump installer in detail and filed with the Department within 30 days of the installation of pump.


Well Owner Information	Well Location
Owner Name: <u>Morgan Planting</u>	Latitude: _____ Longitude: _____
Mailing Address: <u>2612 Hwy 448</u>	Method of Lat/Long (circle one): Conventional Survey,
<u>Shaw</u> <u>Ms.</u> <u>38773</u>	USGS quad, Hand-held GPS, Survey-grade GPS
City State Zip Code	<u>NW 1/4 SW 1/4 Sec 32 Twn 21N Rng 6W</u>
Telephone No. ( ) _____	Distance Direction Nearest Town
	<u>4</u> Miles <u>W</u> of <u>Shaw</u>

Pump Type Circle one	Power Type Circle one
Air Lift      Jet      Submersible	<u>Diesel Engine</u> Gasoline Engine      Natural Gas
Bucket      Piston <u>Turbine</u>	Electric Motor      Hand      Tractor PTO
Centrifugal      Rotary      Flowing Well	Windmill      Other (specify): _____
Other (specify): _____	Horse Power Rating of Motor: <u>60</u>
Date Pump Installed: <u>6-26-08</u>	Setting Depth: <u>60</u> feet
Rated Pump Capacity: <u>2200±</u> Gallons Per Minute	Number of Stages: <u>2</u>

Pump Test Data	Method of Measuring Water Level Circle one
Date Well Tested: _____	Air Line      Electric Measuring Line      Steel Tape
Static Water Level (A): _____ Feet Below Land Surface	Other (specify): _____
Pumping Water Level (B): _____ Feet Below Land Surface	For flowing well, measured shut in head: _____ feet
Drawdown [(B) - (A)]: _____ Feet Below Land Surface	Well yielded _____ GPM with a drawdown of
Test Pumping Rate: _____ Gallons Per Minute	_____ feet after _____ hours of pumping
Duration of Pump Test (minimum 4 hours): _____ hours	


I HEREBY CERTIFY that the above statements are true to the best of my knowledge.

Patrick M. Chism      0695  
 Print Name of Pump Installer and License No. (if applicable)

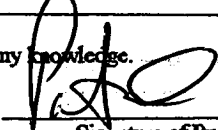  
 Signature of Pump Installer

RECEIVED

JUL 09 2008  
 BY: OLWR

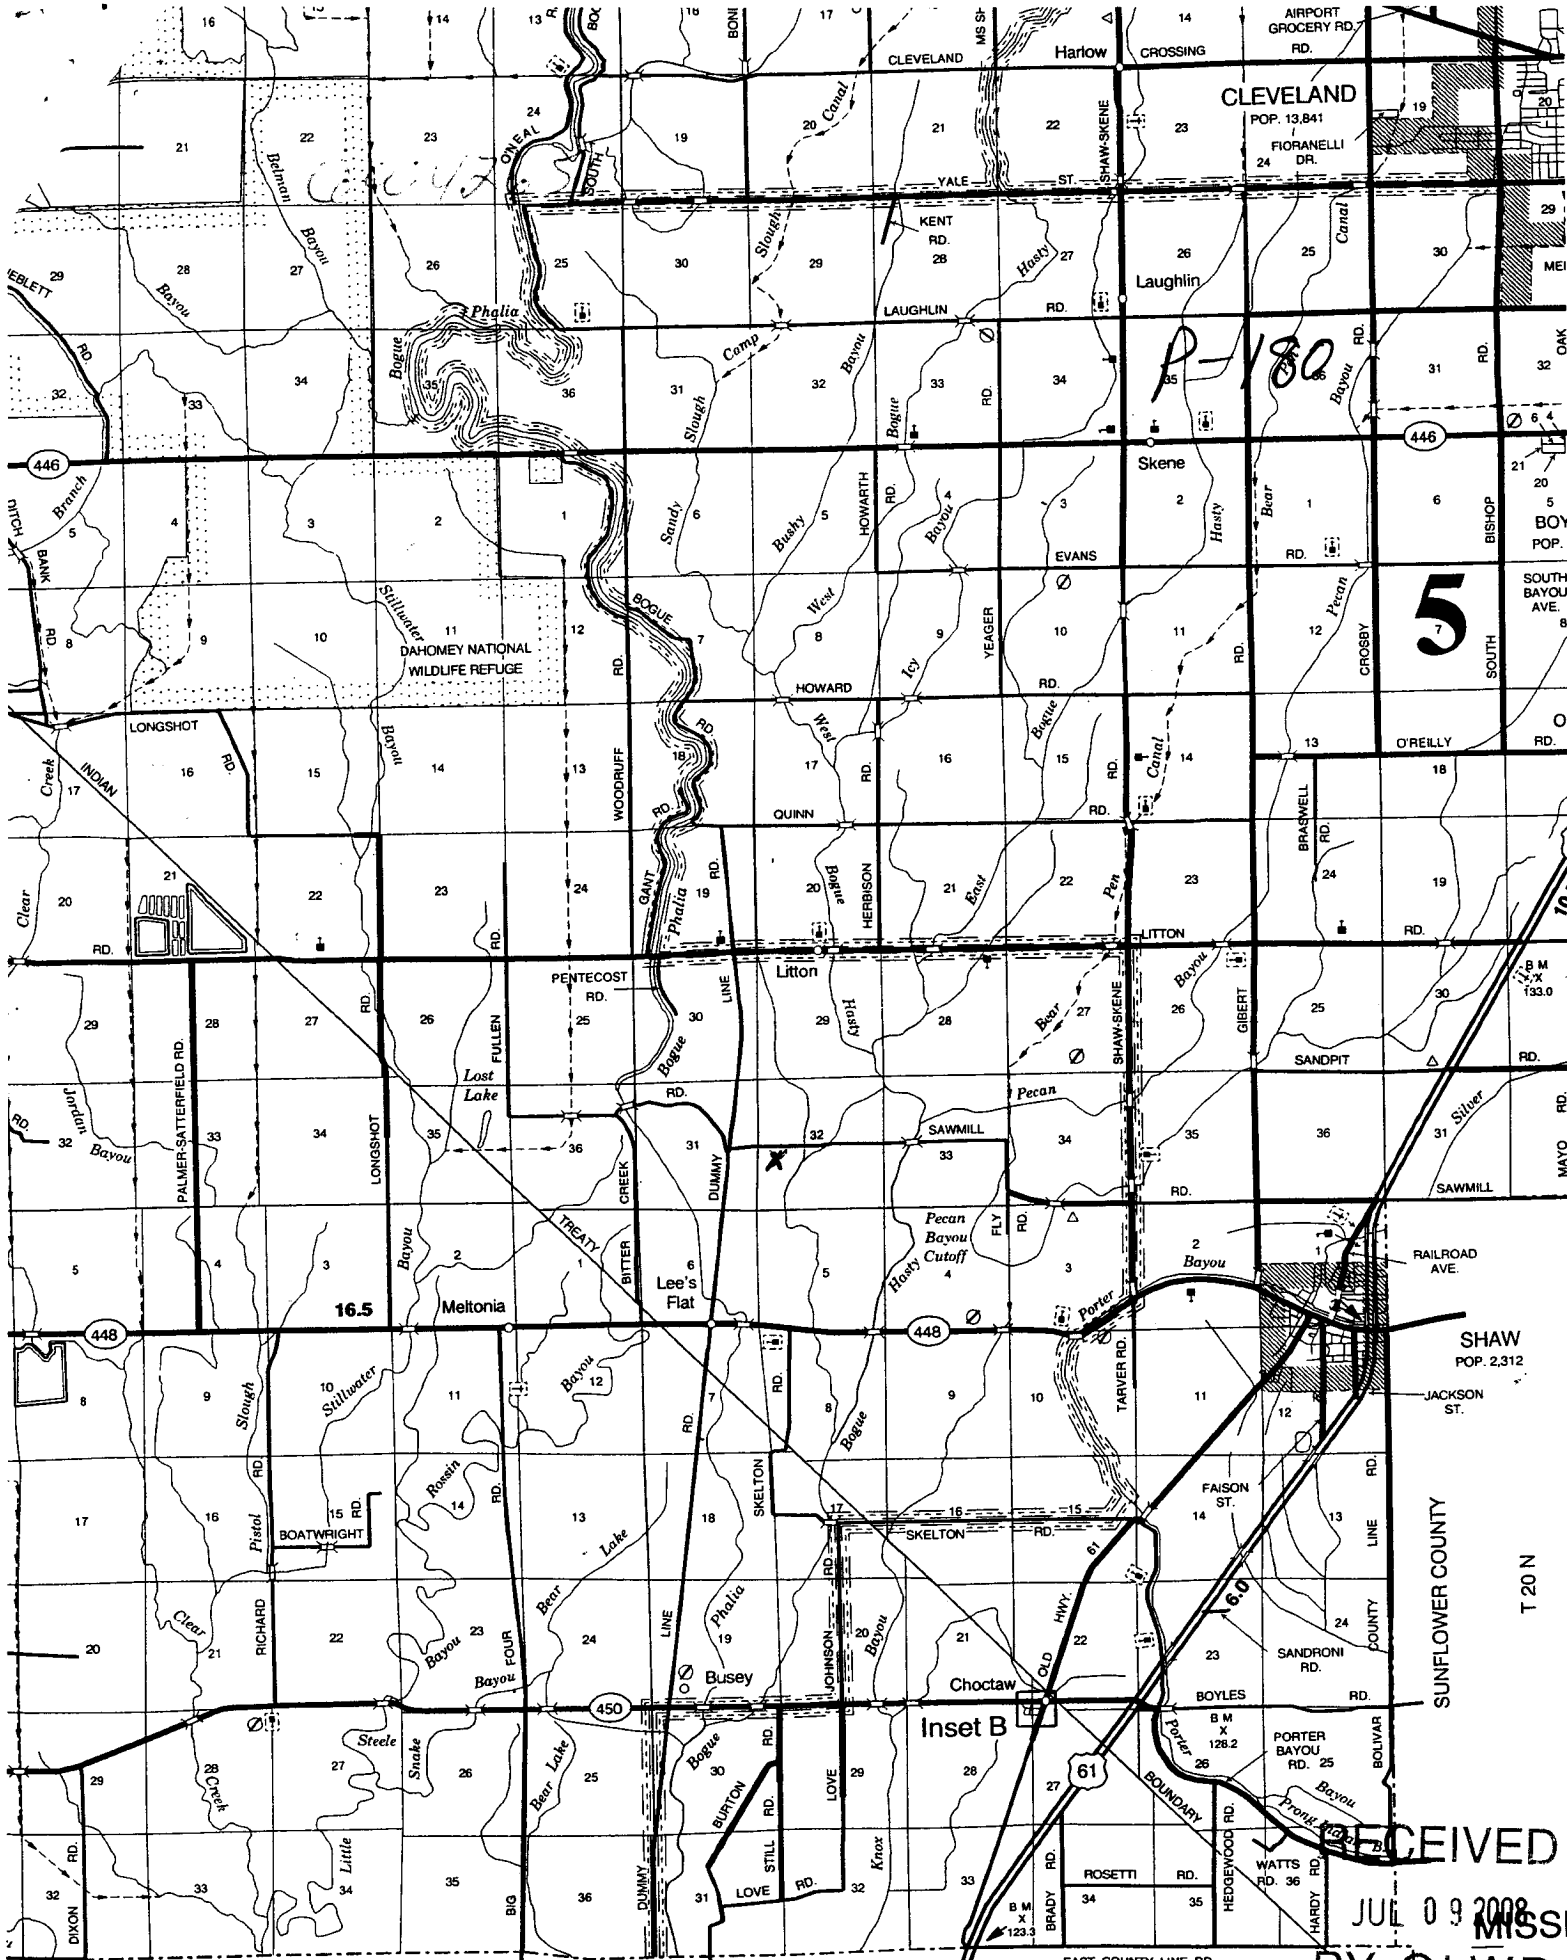

*Morgan Planting Map*

RECEIVED  
 JUL 09 2008  
 MISSISSIPPI  
 BY: OLWR

WASHINGTON COUNTY

EAST COUNTY LINE RD.

SUNFLOWER COUNTY

T 20 N

A-180

16.5

5

BOY POP.

SOUTH BAYOU AVE.

8

OAK

RD.

32

20

5

BISHOP

RD.

21

6

5

BOY

POP.

8

SOUTH

BAYOU

AVE.

20

5

BOY

POP.

8

OAK

RD.

32

20

5

BISHOP

RD.

21

6

5

BOY

POP.

8

SOUTH

BAYOU

AVE.

20

5

BOY

POP.

8

OAK

RD.

32

20

5

BISHOP

RD.

21

6

5

BOY

POP.

8

SOUTH

BAYOU

AVE.

20

5

BOY

POP.

8

OAK

RD.

32

20

5

BISHOP

RD.

21

6

5

BOY

POP.

8

SOUTH

BAYOU

AVE.

20

5

BOY

POP.

8

OAK

RD.

32

20

5

BISHOP

RD.

21

6

5

BOY

POP.

8

SOUTH

BAYOU

AVE.

20

5

BOY

POP.

8

OAK

RD.

32

20

5

BISHOP

RD.

21

6

5

BOY

POP.

8

SOUTH

BAYOU

AVE.

20

5

BOY

POP.

8

OAK

RD.

32

20

5

BISHOP

RD.

21

6

5

BOY

POP.

8

SOUTH

BAYOU

AVE.

20

5

BOY

POP.

8

OAK

RD.

32

20

5

BISHOP

RD.

21

6

5

BOY

POP.

8

SOUTH

BAYOU

AVE.

20

5

BOY

POP.

8

OAK

RD.

32

20

5

BISHOP

RD.

21

6

5

BOY

POP.

8

SOUTH

BAYOU

AVE.

20

5

BOY

POP.

8

OAK

RD.

32

20

5

BISHOP

RD.

21

6

5

BOY

POP.

8

SOUTH

BAYOU

AVE.

20

5

BOY

POP.

8

OAK

RD.

32

20

5

BISHOP

RD.

21

6

5

BOY

POP.

8

SOUTH

BAYOU

AVE.

20

5

BOY

POP.

8

OAK

RD.

32

20

5

BISHOP

RD.

21

6

5

BOY

POP.

8

SOUTH

BAYOU

AVE.

20

5

BOY

POP.

8

OAK

RD.

32

20

5

BISHOP

RD.

21

6

5

BOY

POP.

8

SOUTH

BAYOU

AVE.

20

5

BOY

POP.

8

OAK

RD.

32

20

5

BISHOP

RD.

21

6

5

BOY

POP.

8

SOUTH

BAYOU

AVE.