		ell Report	For Office Use Only:
County: Bo LivA C	BoLiva K Part 1 - Driller's Log		
		nt of Environmental Quality	Aquifer:
Permit #:		nd Water Resources Box 2309	Well #: <u>P192</u>
Driller COOK DRILLING Confle	Jackson, MS 39225		, i i i i i i i i i i i i i i i i i i i
Date drilling completed: 2-8-09		961- 5210	L. S. Elevation:
Date drilling completed 7 - 8 - 0 1	(601)961- 5228 (fax)		E-log #:
State Law requires that this report	he prepared by the lic	ense holder responsible for t	the work and filed with the
Department at the above address w	vithin 30 days of com	pletion of drilling of the well	or borehole.
Information on Well Ov	wner	Well or Bo	rehole Location
(Landowner if borehole is not for		Latituda 37. 29. LA	4 Longitude 20 . 48 421
human Name labot front ta	rned MR.		
where Name Wat ford Farmer SKR.		Method of Lat/Long (circle one): Conventional Survey,	
failing Address: 656 Howa	rd fd	USGS quad, Hand-held	GPS, Survey-grade GPS
		SF 1/ SW 1/ Sec 15	Twn 21N Rng 6W
Boyle M.	5. 38730		
		Distance Direction	of <u>Stane ms</u>
elephone No. (662) 843-384	<i>+</i> 1		u
elephone No. (pm) 0 p = = = =	• •		
	Well / Bor	ehole Data	
Logs run (circle all applicable): No log run Name of organization running log(s): Purpose of borehole (check one): Water We	ell Geotechnical/Geo	logical Investigation Groun	
Seismic S If drilling is not related	SurveyOther (describ to water well constructi	e) on, skip the remainder of this b	lock
Purpose of Well (check one): Home Ir			
If a flowing well, method of flow regulation			
Static Water Level: <u>45</u> feet ab	ove or below (circle one)	land surface Date measured	<u> </u>
Method of Measurement (circle one) sto	eel tape electric tap	e air line other:	······································
Well depth: 120 Well grouted to a de	pth of feet Typ	be of grout (circle one): Neat Ce	ment Bentonite Mix
Casing length: 80 feet Casin	ng diameter: <u>6</u>	inches Type of casing:	PVU
Saraan langth: Un faat Sora	en diameter: <u>16</u>	inches Type of screen:	- <i>Y [[</i>
Scicen renginieei Scie			
Screen slot size: <u>50</u> inches	Setting depth: From	feet to	20 feet
Screen length:ieetscreen Screen slot size:inches Type of completion (circle all applicable):	Setting depth: From Gravel packed Und	erreamed Telescoped Ope	2.0 feet in hole Natural Development
Screen slot size: 50 inches	Setting depth: From Gravel packed Und		2.0 feet in hole Natural Development
Screen slot size: 50 inches	Setting depth: From Gravel packed Und Other (describe):	erreamed Telescoped Ope	2.0 feet in hole Natural Development
Screen slot size: <u>56</u> inches Type of completion (circle all applicable):	Setting depth: From Gravel packed Und Other (describe):	erreamed Telescoped Ope	2.0 feet in hole Natural Development

, Ř, a

۰.,

5


AUG 1 1 2009

BY: OLWR


ALLIN & STAR Assertation in the Second

Will warrist drog they bed formand. Ed.

Earte. 114. 38120

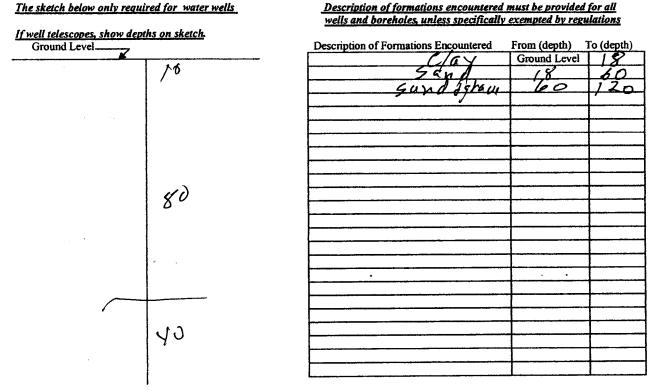

If more than one screen, show location of each on sketch

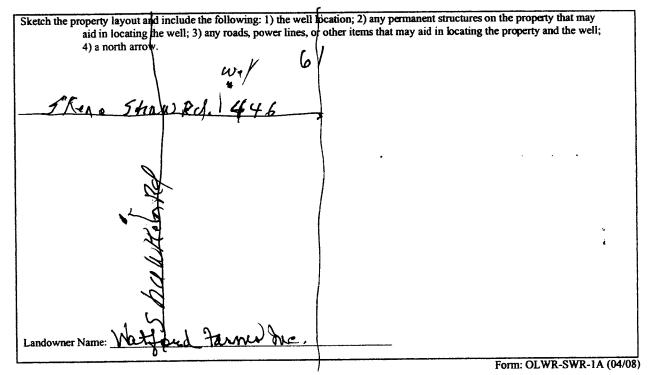

I certify that the well/borehole was drilled, constructed, and completed in accordance with all applicable requirements of the Mississippi Department of Environmental Quality and the Mississippi Department of Health regulations, if applicable, and state

7-8-09

DAilling Lo., mc 289 Print Name of Responsible License Land License No.

laws.

Lost

Date

CEIVED AUG 1 1 2009 BY: OLWR

Signature of License

County: <u>BolivAR</u> Permit #: Driller: <u>Cook Drilling</u> , me Date completed: <u>7-8-09</u> <u>Copy information from block on Part 1</u> This part of the report must be completed by a licensed water well	SCLL REPORT art 2 6 Completion Report t of Environmental Quality and Water Resources Box 2309 MS 39225 961-5210 1-5228 (fax) contractor or a licensed pump installer. A copy of Part 1 of the
This part of the report must be completed by a licensed water well report must be attached and both parts filed with the Department a Well Owner Information Owner Name: No ford farma file Mailing Address: 656 Howard Rd. Mailing Address: 656 Howard Rd. City State Zip Code Telephone No. 662 843 - 3841	contractor or a licensed pump installer. A copy of Part 1 of the t the above address within 30 days of well completion. Well Location Latitude: 33-39-649 Longitude: 90-48-444 37 26 Method of Lat/Long (check one): Conventional Survey, USGS quad, Hand-held GPS, Survey-grade GPS, SE_45W_45ec_15T_21N_R_6W Distance Direction Nearest Town Milesof
Pump Type Circle one Air Lift Jet Submersible Bucket Piston Turbine Centrifugal Rotary Flowing Well Other (specify):	Power Type Circle one Diesel Engine Gasoline Engine Natural Gas Electric Motor Hand Tractor PTO Windmill Other (specify):
Pump Test Data Date Well Tested:	Method of Measuring Water Level Circle one Air Line Electric Measuring Line Steel Tape Other (specify):
I HEREBY CERTIFY that the above statements are true to the best COVE Dulling A.C. 289 Print Name of Pump Installer and License No. (If applicable)	of my knowledge. Signature of Pump Installer Form: OLWR-SHEECEEV

,

AUG 1 1 2009 BY: OLWR

~_____

· . -* *

、 、

.