

County: Bellevue  
 Permit #: GW44016  
 Driller: Cook Drilling Co. Inc.  
 Date drilling completed: 7-7-09

**State Well Report**  
**Part 1 - Driller's Log**  
 Mississippi Department of Environmental Quality  
 Office of Land and Water Resources  
 P.O. Box 2309  
 Jackson, MS 39225  
 (601)961- 5210  
 (601)961- 5228 (fax)

**For Office Use Only:**  
 Aquifer: \_\_\_\_\_  
 Well #: P193  
 L. S. Elevation: \_\_\_\_\_  
 E-log #: \_\_\_\_\_

*State Law requires that this report be prepared by the license holder responsible for the work and filed with the Department at the above address within 30 days of completion of drilling of the well or borehole.*

Information on Well Owner <i>(Landowner if borehole is not for a water well)</i>	Well or Borehole Location
Owner Name: <u>B+S Farms Partnership</u>	Latitude: <u>33° 41' 17.9"</u> Longitude: <u>90° 52' 03.3"</u>
Mailing Address: <u>69 Shivers Drive</u>	Method of Lat/Long (circle one): <u>Conventional Survey</u>
<u>Cleveland</u> <u>MS</u> <u>38732</u>	USGS quad, Hand-held GPS, Survey-grade GPS
City State Zip Code	<u>NW 1/4 NW 1/4 Sec 7 Twn 21N Rng 6W</u>
Telephone No. <u>(662) 843-1032</u>	Distance Direction Nearest Town
	<u>6</u> Miles <u>SW</u> of <u>Skaneateles MS</u>

**Well / Borehole Data**

Date drilling started: 7-7-09 Date drilling completed: 7-7-09 Hole depth: 120 Hole diameter: 28

Location of the source of any surface water used for drilling: \_\_\_\_\_  
 Method of dosing and volume of Chlorine used in drilling and development: \_\_\_\_\_

Logs run (circle all applicable): No log run  Electric  Gamma Ray  Density  Sonic  Neutron  Other: \_\_\_\_\_  
 Name of organization running log(s): \_\_\_\_\_

Purpose of borehole (check one): Water Well  Geotechnical/Geological Investigation  Ground Source Heat Pump   
 Seismic Survey  Other (describe) \_\_\_\_\_

*If drilling is not related to water well construction, skip the remainder of this block*

Purpose of Well (check one): Home  Industrial  Public Supply  Irrigation  Fish Culture  Other: \_\_\_\_\_

If a flowing well, method of flow regulation: Valve \_\_\_\_\_ Other (describe) \_\_\_\_\_

Static Water Level: 42 feet above or below (circle one) land surface Date measured: 2-7-09

Method of Measurement (circle one) steel tape electric tape air line other: \_\_\_\_\_

Well depth: 120 Well grouted to a depth of 10 feet Type of grout (circle one): Neat Cement  Bentonite  Mix

Casing length: 80 feet Casing diameter: 16 inches Type of casing: PVC

Screen length: 40 feet Screen diameter: 16 inches Type of screen: PVC

Screen slot size: 50 inches Setting depth: From 80 feet to 120 feet

Type of completion (circle all applicable): Gravel packed  Underreamed  Telescoped  Open hole  Natural Development   
 Other (describe): \_\_\_\_\_

Top of lap pipe or reduction in casing: \_\_\_\_\_ feet. *If telescoped or more than one screen, describe on next page*

Form: OLWR-SWR-1A (04/08)

RECEIVED  
 AUG 11 2009  
 BY: OLWR

Handwritten notes at the top of the page, including a date "10/10/88" and some illegible text.

Handwritten notes in the middle section, including the phrase "qib... (w/...)" and "and...".


Handwritten notes in the lower middle section, including the phrase "and...".

Handwritten notes in the lower section, including the phrase "and...".

Handwritten notes at the bottom of the page, including the phrase "and...".

The sketch below only required for water wells


If well telescopes, show depths on sketch

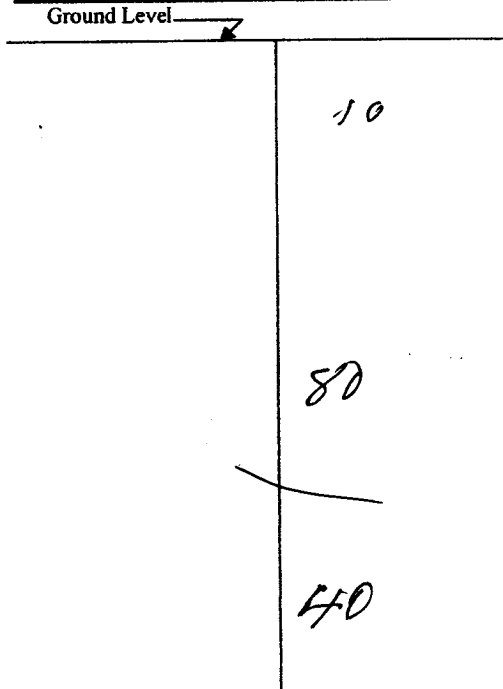

Description of formations encountered must be provided for all wells and boreholes, unless specifically exempted by regulations

Description of Formations Encountered	From (depth)	To (depth)
Clay	Ground Level	45
Sandy Soil	45	60
Gravel (BSE78)	60	130

If more than one screen, show location of each on sketch

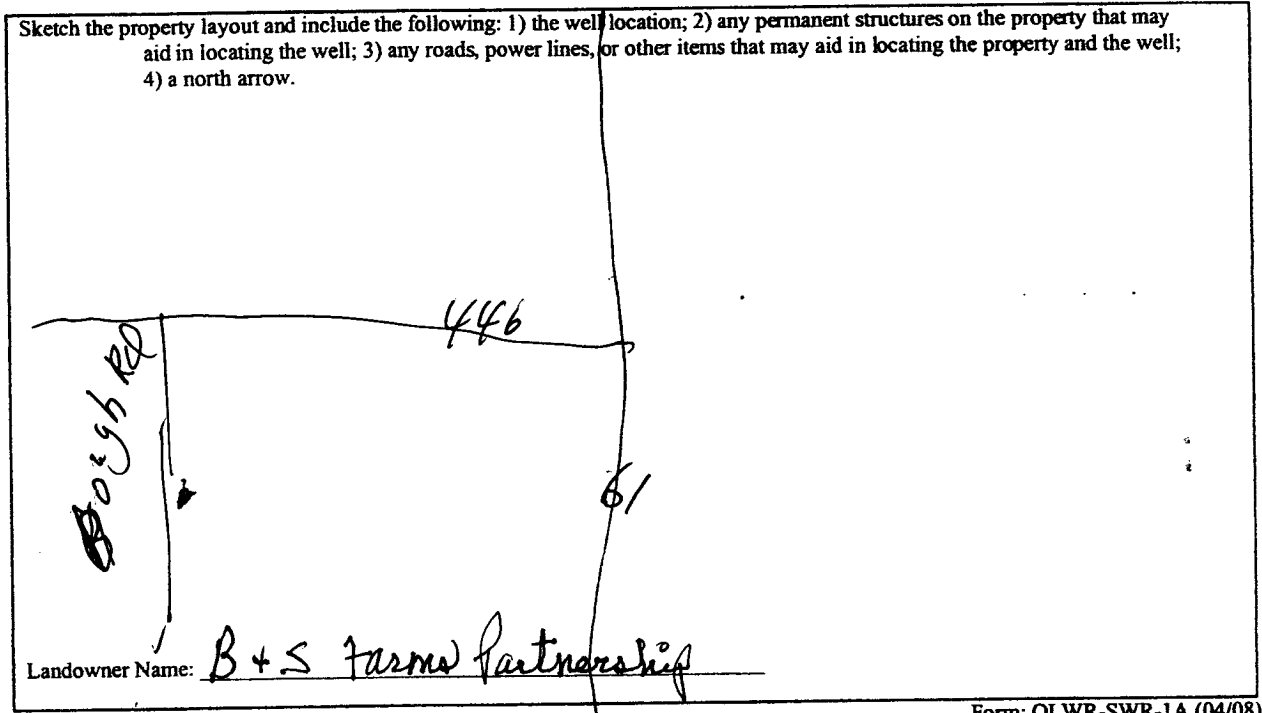

Form: OLWR-SWR-1A (04/08)

I certify that the well/borehole was drilled, constructed, and completed in accordance with all applicable requirements of the Mississippi Department of Environmental Quality and the Mississippi Department of Health regulations, if applicable, and state laws.

Cook Drilling Co, Inc 289 7-7-09 [Signature]  
 Print Name of Responsible Licensee and License No.      Date      Signature of Licensee

RECEIVED  
 AUG 11 2009  
 BY: OLWR

# STATE WELL REPORT

## Part 2

**Pump Installer's Completion Report**  
 Mississippi Department of Environmental Quality  
 Office of Land and Water Resources  
 P.O. Box 2309  
 Jackson, MS 39225  
 (601)961-5210  
 (601)961-5228 (fax)

County: BOLIVAR  
 Permit #: \_\_\_\_\_  
 Driller: COOK DRILLING Co., Inc.  
 Date completed: 7-7-09  
*Copy information from block on Part 1*

**For Office Use Only:**

Aquifer: \_\_\_\_\_  
 Well #: P 193  
 Elevation: \_\_\_\_\_

*This part of the report must be completed by a licensed water well contractor or a licensed pump installer. A copy of Part 1 of the report must be attached and both parts filed with the Department at the above address within 30 days of well completion.*

Well Owner Information	Well Location
Owner Name: <u>B+S Farms Partnership</u>	Latitude: <u>33-46-10.4</u> Longitude: <u>90-52-29.7</u>
Mailing Address: <u>69 Shivers Drive</u>	Method of Lat/Long (check one): Conventional Survey <input checked="" type="checkbox"/> <sup>10</sup> <sub>03"</sub>
<u>Cleveland</u> MS. <u>38732</u>	USGS quad _____, Hand-held GPS _____, Survey-grade GPS _____
City State Zip Code	<u>NW 1/4 NW 1/4 Sec 7 T21N R 6W</u>
Telephone No. <u>(662) 843-1032</u>	Distance Direction Nearest Town <u>6</u> Miles <u>SW</u> of <u>Skeneo, MS</u>

Pump Type Circle one	Power Type Circle one
Air Lift <input type="checkbox"/> Jet <input type="checkbox"/> <u>Submersible</u> <input checked="" type="checkbox"/>	Diesel Engine <input type="checkbox"/> Gasoline Engine <input type="checkbox"/> Natural Gas <input type="checkbox"/>
Bucket <input type="checkbox"/> Piston <input type="checkbox"/> Turbine <input type="checkbox"/>	Electric Motor <input checked="" type="checkbox"/> Hand <input type="checkbox"/> Tractor PTO <input type="checkbox"/>
Centrifugal <input type="checkbox"/> Rotary <input type="checkbox"/> Flowing Well <input type="checkbox"/>	Windmill <input type="checkbox"/> Other (specify): _____
Other (specify): _____	Horse Power Rating of Motor: <u>40</u>
Date Pump Installed: <u>7-7-09</u>	Setting Depth: <u>70</u> feet
Rated Pump Capacity: <u>1600</u> Gallons Per Minute	Number of Stages: <u>1</u>

Pump Test Data	Method of Measuring Water Level Circle one
Date Well Tested: _____	Air Line <input type="checkbox"/> Electric Measuring Line <input type="checkbox"/> Steel Tape <input type="checkbox"/>
Static Water Level (A): <u>42</u> Feet Below Land Surface	Other (specify): _____
Pumping Water Level (B): _____ Feet Below Land Surface	For flowing well, measured shut in head: _____ feet
Drawdown [(B) - (A)]: _____ Feet Below Land Surface	Well yielded _____ GPM with a drawdown of _____ feet after _____ hours of pumping
Test Pumping Rate: _____ Gallons Per Minute	
Duration of Pump Test (minimum 4 hours): _____ hours	

I HEREBY CERTIFY that the above statements are true to the best of my knowledge.

Cook Drilling Co., Inc. 287  
 Print Name of Pump Installer and License No. (if applicable)

Silvius Cook  
 Signature of Pump Installer

Form: OLWR-SWR-1B (04/08)

RECEIVED

AUG 11 2009

BY: OLWR

PROBATION DEPARTMENT

1925

PROBATION DEPARTMENT  
OFFICE

PROBATION DEPARTMENT  
OFFICE

