County:	Bolivar	
Permit #:	GW-4564	7 /
	Irrigation Equipment	
	ing completed:	03/31/2012

State Well Report Part 1 - Driller's Log

Mississippi Department of Environmental Quality
Office of Land and Water Resources
P.O. Box 2309
Jackson, MS 39225
(601) 961-5210
(601) 961-5228 (fax)

	For Office Use Only:
Aquifer:	
Well #:	P218
L.S. Elevation	
E-log #:	

State Law requires that this report be prepared by the license holder responsible for the work and filed with the Department, at the above address within 30 days of completion of drilling of the well or borehole.

D	epartment at the above address within 30	days of completion of drilling of the well or borehole.
	Information on Well Owner	Well or Borehole Location
`	wner if borehole is not for a water well)	
Owner Name	Duke H. Morgan Sr.	Latitude: 33 ° 37 ' 00 " Longitude: 90 ° 51 ' 36 "
Mailing Address:	2612 Hwy 448	Method of Lat/Long (check one): Conventional Survey,
		☐ USGS quad, ☐ Hand-held GPS, ☐ Survey-grade GPS
	Shaw Ms 38773	SE 1/4 SW 1/4 Sec 31 \(\square \) Twn 21N Rng 6W
	City State Zip cod	Distance Direction Nearest Town
Telephone No.	() -	5 MilesWest of _Shaw
	We	ell / Borehole Data
Date drilling starte	ed: 03/31/2012 Date drilling completed:	03/31/2012 Hole depth: 126 Hole diameter: 18"
	urce of any surface water used for drilling: <u>Su</u> and volume of Chlorine used in drilling and dev	
	! ! 1 (-)	Gamma Ray
Purpose of boreho	le (check one): Water Well Geotec	chnical/Geological Investigation Ground Source Heat Pump
	☐ Seismic Survey ☐ O	Other (describe)
		vell construction, skip the remainder of this block
Purpose of Well (c	heck one)	
If flowing, method	of flow regulation: Valve Oth	ner (describe)
Static Water Level	: 42 feet above or below (check one)	□ land ⊠ surface Date measured: 04/06/2012
Method of Measur	ement (check one) ⊠ steel tape □ electric ta	ape 🗌 air line 🔲 other:
Well depth: 126	Well grouted to a depth of fe	et Type of grout (check one): Neat Cement Bentonite Mix
Casing length:	feet Casing diameter: 10	inches Type of casing: PVC
Screen length: _4	feet Screen diameter: 10	inches Type of screen: PVC
Screen slot size:	.050 inches Setting depth: 1	From <u>87</u> feet to <u>126</u> feet
Type of completion	n (check all applicable):	☐ Underreamed ☐ Telescoped ☐ Open hole ☐ Natural Development
	Other (describe):	
Top of lap pipe or	reduction in casing: fe	eet. If telescoped or more than one screen, describe on next page

Form: OLWR-SWR-1A (04/08)

RECEIVED

MAY 0 1 2012

BY: OLWR

Ground level

Description of formations encountered must be provided for all wells and boreholes, unless specifically exempted by regulations

If well telescopes, show depths on sketch.	

From (depth) To (depth) Description of Formations Encountered Ground level 23 24 33 Fine Sand & Clay 49 34 **Fine Sand & Gravel** 50 126 **Medium Sand & Gravel**

If more than one screen, show location of each on sketch

aid i	layout and include the following: 1) the well location; 2) any perm locating the well; 3) any roads, power lines, or other items that morth arrow.	nanent structures on the property that may nay aid in locating the property and the well;
Landowner Name:	Duke H. Morgan Sr.	_
		Form: OLWR-SWR-1A (04/08)

I certify that the well/borehole was drilled, constructed, and completed in accordance with all applicable requirements of the Mississippi Department of Environmental Quality and the Mississippi Department of Health regulations, if applicable, and state

Patrick Chism

0695 Print Name of Responsible Licensee and License No. 04/25/2012

Signature of Licensee

RECEIVED

MAY 0 1 2012

BY: OLWR

STATE WELL REPORT

Part 2 Pump Installer's Completion Report

Mississippi Department of Environmental Quality Office of Land and Water Resources P.O. Box 2309 Jackson, MS 39225 (601) 961-5210 (601) 961-5228 (fax)

	For Office Use Only:	
Aquifer:		
Well #:	P218	
Elevation:		

This part of the report must be completed by a licensed water well contractor or a licensed pump installer. A copy of Part 1 of the

report must be	attached and both parts	filed with the Department	t at the above address within 30 days of well completion.
	Well Owner Inform	nation	Well Location
Owner Name: _D	Duke H. Morgan Sr.		Latitude: 33 37' 00 N Longitude: 90 51' 36 W
Mailing Address:	2612 Hwy 448		Method of Lat/Long (check one): Conventional Survey,
			☐ USGS quad, ☑ Hand-held GPS, ☐ Survey-grade GPS
	Shaw	Ms 38773	SE 1/4 SW 1/4 Sec 31 T 21N R 6W
	City	State Zip code	Distance Direction Nearest Town
Telephone No.	() -		5 Miles West of Shaw
	Pump Type		Power Type
	Check one		Check one
Air Lift	☐ Jet	Submersible	☐ Diesel Engine ☐ Gasoline Engine ☐ Natural Gas
Bucket	☐ Piston	☐ Turbine	☑ Electric Motor ☐ Hand ☐ Tractor PTO
Centrifugal	Rotary	☐ Flowing Well	Windmill Other (specify):
Other (specify):			Horse Power Rating of Motor: 30
Date Pump Installe	ed: 04/06/2012		Setting Depth: 60 feet
Rated Pump Capac	city <u>1200+/-</u>	Gallons Per Minute	Number of Stages: 2
	Pump Test Dat	a	Method of Measuring Water Level
			Check one
1			☐ Air Line ☐ Electric Measuring Line ☐ Steel Tape
Static Water Level	(A):	Feet Below Land Surface	Other (specify):
Pumping Water Le	evel (B):	Feet Below Land Surface	
Drawdown [(B) -	(A)]:	Feet Below Land Surface	For flowing well, measured shut in head: feet
Test Pumping Rate	·	Gallons Per Minute	Well yielded GPM with a drawdown of
Duration of Pump	Test (minimum 4 hours):	hours	feet after hours of pumping
This is for (c	heck one): Nev	w Well Replacen	nent of Existing Pump Repair of Existing Pump
I HEREBY CERT	TFY that the above statem	ents are true to the best of m	y knowledge RECEIVED
Patrick Chism		0695	You
Print Name of Po	ump Installer and License	No. (if applicable)	Signature of Pump Installer MAY 0 1 2012


Form: OLWR-SWR-1C (07-09)
BY: OLWR

County: Bolivar
Permit #: GW-45647

Driller: Irrigation Equipment

Date drilling completed: 03/31/2012

Copy information from block on Part 1

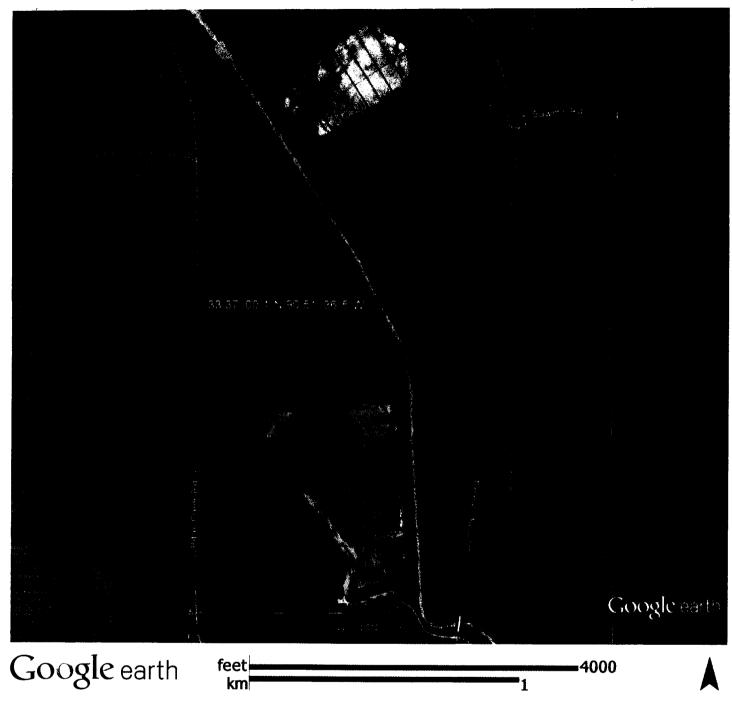

RECEIVED

MAY 0 1 2012

BY: OLWR