

BOLIVAR

MISSISSIPPI BOARD OF WATER COMMISSIONERS

P: - 1001

7-23-60

WATER WELL DRILLERS LOG

Date: 7/23, 1960, Driller: Bailey Drilling Co. County: Bolivar Washington

(1) Owner of Land: Joe Graziosa (Name)

Shaw, Miss. (Bolivar County) (Address)

(2) Location: 1/4, 1/4, Sec. T. R. 2 miles North of Shaw (distance) (direction) (Nearest Town)

(3) Topography: Flat (Hilly) (Flat) (Level)

(4) Purpose of Well: Irrigation (Domestic, Irrigation, Municipal, Industrial, Other)

Description & Color of Materials Sand, Clay, Red Clay, Shell, etc.	Thick- ness Feet	Depth Feet
Clay	20	20
Sand	40	60
Sand + Gravel	60	120

Information upon completion of well:

(1) Diameter 8 inches.

(2) Total Depth 105 feet.

(3) Water Level 13 1/2 feet below top of ground.

(4) Cased to 75, Size 8

(5) Screen: Size 8, Length 30 ft.


(6) Were any formations sealed against pollution?

yes, X no.

If YES depth of formation

Why

Drillers Remarks:

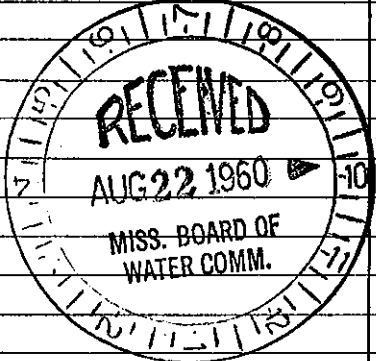

Well

(Use Back Side)

this copy to Board of Water Commissioners 429 Miss. St. Jackson. N