

~~504148~~

MISSISSIPPI BOARD OF WATER COMMISSIONERS

Q-31
4-30-66

WATER WELL DRILLERS LOG

Boliva

Date: April 30, 1966, Driller: Butane Gas Co. of Greenwood, Leflore County

CODED

(Name)

(1) Owner of Land: Joe McCain
(Name)
Cleveland, Miss.
(Address)

(2) Location: 1/4, 1/4, Sec. 4 T4RS,
6 miles N.E. of Cleveland
(distance) (direction) (Nearest Town)

(3) Topography: flat
(Hilly) (Flat) (Level)

(4) Purpose of Well: domestic
(Domestic Irrigation, Municipal, Industrial, Other)

Description & Color of Materials Sand, Clay, Red Clay, Shell, etc.	Thick- ness Feet	Depth Feet
Clay	35	35
Sand	33	68
Sand & pea gravel	58	126
Clay	8	134
Sand & clay St.	117	251
Sand	42	293
Shale sand st.	313	606
H. P. sand	62	668
Shale	12	680

Information upon completion of well:

(1) Diameter 4 x 2 inches.

(2) Total Depth 680 feet.

(3) Water Level 31 ft. feet below top of ground.

(4) Cased to 650', Size 4 x 2

(5) Screen: Size 2", Length 20'

(6) Were any formations sealed against pollution?
no yes, x no.

If YES depth of formation _____


Why _____

Drillers Remarks: _____

Yield in GPM : 18

Type Power: electric electric

CODED

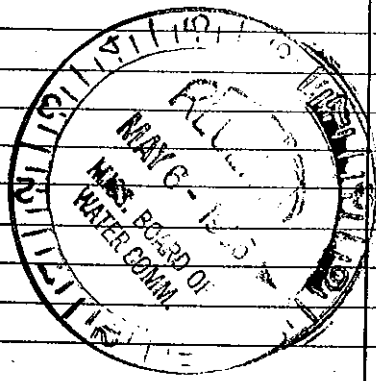

Well No.

tain this copy for your office files.

(Use Back Side)