

BOLIVAR MISSISSIPPI BOARD OF WATER COMMISSIONERS


Q 34
12-16-64

WATER WELL DRILLERS CODED

Date: 12/16, 1964, Driller: Deltawell Supply County Bolivar
(Name)

(1) Owner of Land:	Description & Color of Materials Sand, Clay, Red Clay, Shell, etc.	Thick- ness Feet	Depth Feet
(Name) <u>J. J. Cup</u> (Address) <u>Boyle Miss.</u>	<u>Last Log Book.</u>		
(2) Location: <u>1/4</u> , <u>1/4</u> , Sec. <u>9</u> T <u>21</u> R <u>5</u> <u>1</u> miles <u>So</u> , of <u>Boyle</u> (distance) (direction) (Nearest Town)			
(3) Topography: <input checked="" type="checkbox"/> (Hilly) <input type="checkbox"/> (Flat) <input type="checkbox"/> (Level)			
(4) Purpose of Well: (Domestic Irrigation Municipal, Industrial, Other)	<u>sand med.</u>	<u>566</u> <u>40606</u>	
Information upon completion of well:			
(1) Diameter <u>4x2</u> inches.			
(2) Total Depth <u>604</u> feet.			
(3) Water Level <u>22 ft</u> feet below top of ground.			
(4) Cased to _____, Size _____			
(5) Screen: Size <u>2"</u> , Length <u>20 ft</u>			
(6) Were any formations sealed against pollution? _____ yes, _____ no.			
If YES depth of formation _____			
Why _____			
Drillers Remarks: _____			

CODED

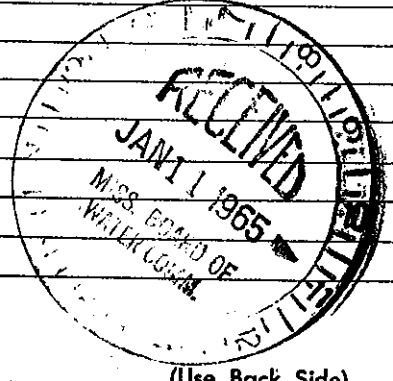

(Use Back Side)

Well No.

Mail this copy to Board of Water Commissioners 429 Miss. St. Jackson, Miss.