

BOLIVAR MISSISSIPPI BOARD OF WATER COMMISSIONERS

Q36
6-24-64

WATER WELL DRILLER CODED

Date: 7/24, 1964, Driller: Delta Well Supply Co County Bolivar
(Name) SANDRONI

(1) Owner of Land	Description & Color of Materials Sand, Clay, Red Clay, Shell, etc.	Thick- ness Feet	Depth Feet
<u>Ray Sandroni</u> (Name) <u>Shaw Miss</u> (Address)	<u>Sandy loam</u>	<u>16</u>	
(2) Location: <u>1/4</u> , <u>1/4</u> , Sec. <u>22 T.21R.5</u>	<u>Clay & Fine gravel</u>	<u>60</u>	<u>76</u>
<u>1/2</u> miles <u>North</u> , of <u>Shaw</u> (distance) (direction) (Nearest Town)	<u>Mill sand</u>	<u>14</u>	<u>90</u>
(3) Topography: <input checked="" type="checkbox"/> (Hilly) <input type="checkbox"/> (Flat) <input type="checkbox"/> (Level)	<u>Coarse sand some gravel</u>	<u>47</u>	<u>137</u>
(4) Purpose of Well: <u>Irrigation</u> (Domestic) <input checked="" type="checkbox"/> Irrigation Municipal, Industrial, Other)			

Information upon completion **CODED**

(1) Diameter 12 inches.

(2) Total Depth 137 feet.

(3) Water Level 18 feet below top of ground.

(4) Cased to _____, Size _____.


(5) Screen: Size 12, Length 40 ft.

(6) Were any formations sealed against pollution?
_____ yes, _____ no.

If YES depth of formation _____

Why _____

Drillers Remarks: _____

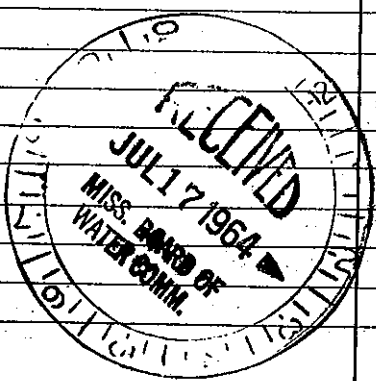

Well No.

(Use Back Side)

Mail this copy to Board of Water Commissioners 429 Miss. St. Jackson, Miss.