

BOLIVAR MISSISSIPPI BOARD OF WATER COMMISSIONERS

Q 310

Q 56
9-10-60

WATER WELL DRILLERS LOG

Date: 9/10, 1960, Driller: Delta Well Supply Co. County: Bolivar
(Name)


(1) Owner of Land:	Description & Color of Materials Sand, Clay, Red Clay, Shell, etc.	Thick- ness Feet	Depth Feet
<u>S. J. Gregory</u> (Name) <u>Boyle Marsh</u> (Address)	<u>sand-clay</u>	<u>21</u>	<u>21</u>
(2) Location: <u>Center NW 1/4, Sec. 13 T21R10</u> <u>3</u> miles <u>S. E.</u> of <u>Boyle</u> (distance) (direction) (Nearest Town)	<u>Fine sand</u>	<u>16</u>	<u>37</u>
(3) Topography: <u>Level</u> (Hilly) (Flat) (Level)	<u>Blue clay</u>	<u>4</u>	<u>41</u>
(4) Purpose of Well: <u>Domestic</u> (Domestic Irrigation Municipal, Industrial, Other)	<u>Fine sand</u>	<u>22</u>	<u>63</u>
	<u>Medium sand</u>	<u>19</u>	<u>82</u>
	<u>" " gravel</u>	<u>22</u>	<u>104</u>
	<u>Sand & Gravel</u>	<u>22</u>	<u>127</u>
	<u>blue clay + sandstone</u>	<u>158</u>	<u>285</u>
	<u>sand medium</u>	<u>19</u>	<u>304</u>
	<u>blue clay</u>	<u>3</u>	<u>307</u>
	<u>sand coarse</u>	<u>21</u>	<u>328</u>

Information upon completion of well:

- (1) Diameter 4 inches. x 2 1/2
- (2) Total Depth 328 feet.
- (3) Water Level 19 feet below top of ground.
- (4) Cased to _____, Size _____
- (5) Screen: Size 2 1/2, Length 30 ft.
- (6) Were any formations sealed against pollution?
_____ yes, no.

CODED

If YES depth of formation _____
Why _____
Drillers Remarks: _____

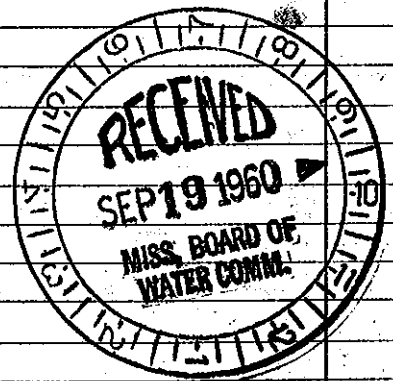

Well No.

(Use Back Side)