

Boliver
 Q 57
 6-66

MISSISSIPPI BOARD OF WATER COMMISSIONERS

WATER WELL DRILLERS LOG

Boliver

Date: 6/9, 1966, Driller: Butane Gas Co. County: Leflore

(Name)

	Description & Color of Materials Sand, Clay, Red Clay, Shell, etc.	Thick- ness Feet	Depth Feet
(1) Owner of Land: <u>Roark Bros.</u> (Name) <u>Boyle, Miss.</u> (Address)	<u>Clay</u>	<u>13</u>	<u>13</u>
	<u>Clay</u>	<u>10</u>	<u>23</u>
(2) Location: <u>SW 1/4, SW 1/4, Sec. 6 T14R1W</u>	<u>Sand & Gravel</u>	<u>10</u>	<u>33</u>
	" "	<u>10</u>	<u>43</u>
<u>2 1/2</u> miles <u>SW</u> , of <u>Boyle</u>	" "	<u>10</u>	<u>53</u>
(distance) (direction) (Nearest Town)	" "	<u>10</u>	<u>63</u>
(3) Topography: <input checked="" type="checkbox"/> (Level)	" "	<u>10</u>	<u>73</u>
(4) Purpose of Well: <u>Irrigation</u>	" "	<u>10</u>	<u>83</u>
(Domestic Irrigation Municipal, Industrial, Other)	" "	<u>10</u>	<u>93</u>
	" "	<u>10</u>	<u>103</u>

Information upon completion of well:


- (1) Diameter 16 inches.
- (2) Total Depth 103 feet.
- (3) Water Level 16 feet below top of ground.
- (4) Cased to 63, Size 16.
- (5) Screen: Size 16, Length 40.
- (6) Were any formations sealed against pollution?
 yes, no.

If YES depth of formation _____

Why _____

Drillers Remarks: _____

CODED

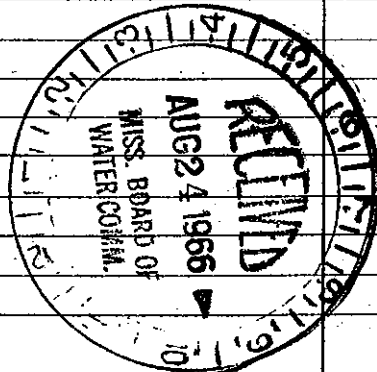

Well No.

(Use Back Side)

Mail this copy to Board of Water Commissioners 429 Miss. St. Jackson, Miss.