

Q 58
9-66

WATER WELL DRILLERS LOG

Date: 9/20, 1966, Driller: Dutton Well & Supply Co County Bolivar
(Name)

(1) Owner of Land: C.S. McNeal
(Name)
P.F.D. Boyle
(Address)

(2) Location: 8 W 1/4, N W 1/4, Sec. 9 T21R54
1 1/2 miles So of Boyle
(distance) (direction) (Nearest Town)

(3) Topography: _____
(Hilly) (Flat) (Level)

(4) Purpose of Well: Domestic
(Domestic Irrigation
Municipal, Industrial, Other)

Description & Color of Materials Sand, Clay, Red Clay, Shell, etc.	Thick- ness Feet	Depth Feet
<u>sand clay</u>	<u>45</u>	<u>45</u>
<u>" & gravel</u>	<u>75</u>	<u>120</u>
<u>shale & clay</u>	<u>25</u>	<u>145</u>
<u>clay</u>	<u>15</u>	<u>160</u>
<u>shale</u>	<u>25</u>	<u>185</u>
<u>sand fine</u>	<u>245</u>	<u>430</u>
<u>shale hard</u>	<u>65</u>	<u>495</u>
<u>sand med</u>	<u>15</u>	<u>510</u>
<u>shale hard</u>	<u>20</u>	<u>530</u>
<u>fine sand & shell</u>	<u>30</u>	<u>560</u>
<u>shale hard</u>	<u>20</u>	<u>580</u>
<u>sand med to coarse</u>	<u>40</u>	<u>620</u>
<u>shale hard ?</u>		

Information upon completion of well:

(1) Diameter 4 1/2 inches.

(2) Total Depth 620 feet.

(3) Water Level 21 feet below top of ground.
125' 4"

(4) Cased to 475', Size 2"


(5) Screen: Size 2", Length 20 ft.

(6) Were any formations sealed against pollution?
_____ yes, _____ no.

If YES depth of formation _____

Why _____

Drillers Remarks: _____

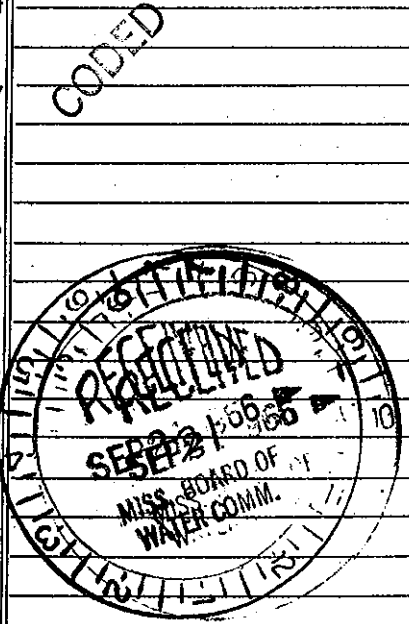

(Use Back Side)

Well No.