

Bolivar  
Q 59  
10-66

MISSISSIPPI BOARD OF WATER COMMISSIONERS

WATER WELL DRILLERS LOG

Date: Oct. 10, 1966, Driller: Burtane W. G. of Greenwood County *Bolivar*  
(Name) Lefflore

(1) Owner of Land: W. E. Lynchard  
(Name)  
Rt. 1 Shaw, Miss.  
(Address)

(2) Location: SW 1/4, NE 1/4, Sec. 22 T21R5W  
7 miles NE of Shaw  
(distance) (direction) (Nearest Town)

(3) Topography: Flat  
(Hilly) (Flat) (Level)

(4) Purpose of Well: Domestic  
(Domestic Irrigation  
Municipal, Industrial, Other)

Description & Color of Materials Sand, Clay, Red Clay, Shell, etc.	Thick- ness Feet	Depth Feet
Clay	18	18
Sand	98	116
Sand & Gravel	69	185
Sand & Clay	24	212
Clay	94	306
Sand	283	589
Clay	50	639
Sandy Shale	29	668
Sand & Shale	42	710
Shale	8	718
Hard Packed Sand	37	755
Shale	48	803
Sand	49	852
Shale	100	952

Information upon completion of well:

(1) Diameter 4 3/4 inches.

(2) Total Depth 952 feet.

(3) Water Level 23 feet below top of ground.

(4) Cased to 819, Size 4" X 2"

(5) Screen: Size 2", Length 20 ft.


(6) Were any formations sealed against pollution?  
 yes,  no.

If YES depth of formation \_\_\_\_\_

Why \_\_\_\_\_

Drillers Remarks: \_\_\_\_\_

CODED

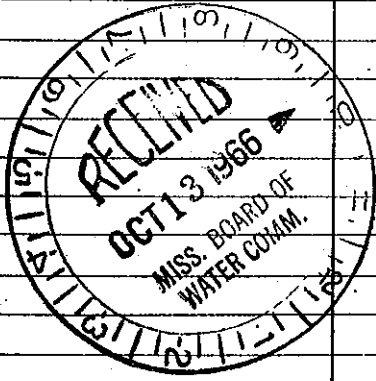

(Use Back S...

Mail this copy to Board of Water Commissioners 429 M...