

BOLIVAR
 78
 2-5-80

MISSISSIPPI
 BOARD OF WATER COMMISSIONERS
 416 North State Street
 Jackson, Mississippi 39201

COPIED

WATER WELL DRILLERS LOG

2/6/80 19 DICK WELL DRILL BOLIVAR
 date well completed firm name county well located


LANDOWNER: C.A. Glass Lyon
 Shaw, MS.
 (mailing address)

description of formations encountered	from	to
TOP SOIL & CLAY	0	13
BROWN SAND	13	23
GRAY SAND	23	33
COURSE SAND & GRAVEL	33	113

WELL LOCATION:
 sec. 19 T. 21 N. R. 5 E
 3 miles N of Shaw
 (distance) (direction) (nearest town)

WELL PURPOSE: FRR
 (home, irrigation, municipal, industrial)

- WELL COMPLETION DATA:
- (1) diameter (inches) 12
 - (2) total depth (feet) 113
 - (3) static water level (feet) 22 below above top of ground.
 - (4) casing 23 (material) (depth)
 12 (size) if telescope see back.
 - (5) screen 40 73 (length) (depth to top)
 12 (size) steel (material)
 - (6) pump 40 1800 (HP) (yield gpm)
 Diesel (type power)
 - (7) electric log no (yes or no)
 (organization running log)
 - (8) how well bottom plugged steel
 plate

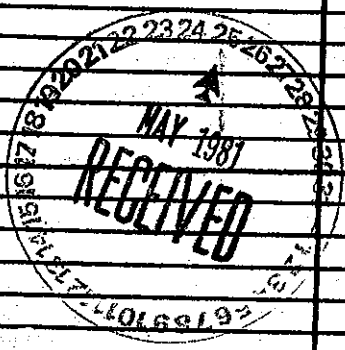

DRILLERS REMARKS:
 wet