

Bolivar
 180
 2/4/80
 2/4/80

MISSISSIPPI
 BOARD OF WATER COMMISSIONERS
 416 North State Street
 Jackson, Mississippi 39201

WATER WELL DRILLERS LOG

CODED

date well completed 19 80 firm name Dyer county well located Bolivar

LANDOWNER:
GAY SANDRONI
SHAW
 (mailing address)


description of formations encountered	from	to
Clay	0	28
fine sand	25	38
sand	38	48
sand & gravel	48	103

WELL LOCATION:
 sec. 28 T. 18 N. R. 5 E.
3 miles 21 miles 3 miles
 (distance) (direction) (nearest town)

WELL PURPOSE:
 (home, irrigation, municipal, industrial)

- WELL COMPLETION DATA:
- (1) diameter (inches) 10"
 - (2) total depth (feet) 103'
 - (3) static water level (feet) 22' below above top of ground.
 - (4) casing steel, 103'
 (material) (depth)
10"
 (size) If telescope see back.
 - (5) screen 40', 63'
 (length) (depth to top)
10", steel
 (size) (material)
 - (6) pump 30, 1200
 (HP) (yield gpm)
propane
 (type power)
 - (7) electric log (yes or no) _____
 (organization running log) _____
 - (8) how well bottom plugged plate

CODED

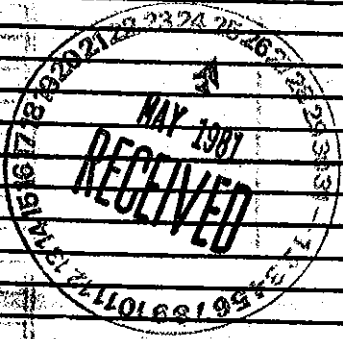

DRILLERS REMARKS: