

MISSISSIPPI DEPARTMENT OF NATURAL RESOURCES

Bureau of Land and Water Resources

Southport Mall

P.O. Box 10631

Jackson, Mississippi 392

WATER WELL DRILLERS LOG

CODED

Bolivar
Q 81
7/23/81

7-23 1981 DR Well + IRR. Bolivar
date well completed firm name county well located

LANDOWNER: <u>Michael Terzetti</u>	description of formations encountered	from	to
<u>SNOW, Miss.</u> (mailing address)	<u>sand</u>	<u>13</u>	<u>23</u>
	<u>sand</u>	<u>23</u>	<u>33</u>
	<u>sand</u>	<u>33</u>	<u>43</u>
	<u>sand/gravel</u>	<u>43</u>	<u>53</u>
	<u>sand/gravel</u>	<u>53</u>	<u>63</u>
	<u>gravel</u>	<u>63</u>	<u>73</u>
	<u>gravel</u>	<u>73</u>	<u>83</u>
	<u>gravel</u>	<u>83</u>	<u>93</u>
	<u>gravel</u>	<u>93</u>	<u>103</u>
	<u>gravel</u>		

WELL LOCATION:
sec. 31 T. 22 N. R. 5 E.
1 miles EAST of SNOW
(distance) (direction) (nearest town)

WELL PURPOSE:
(home, irrigation, municipal, industrial)

WELL COMPLETION DATA:

(1) diameter (inches) 12

(2) total depth (feet) 103'

(3) static water level (feet) 22' below above top of ground.

(4) casing Steel, 63'
(material) (depth)

12 If telescope see back.
(size)

(5) screen 40, 63'
(length) (depth to top)

12", Steel
(size) (material)


(6) pump 40, 1500
(HP) (yield gpm)

Diesel
(type power)

(7) electric log Yes No
(yes or no)

None
(organization running log)

(8) how well bottom plugged Plastic

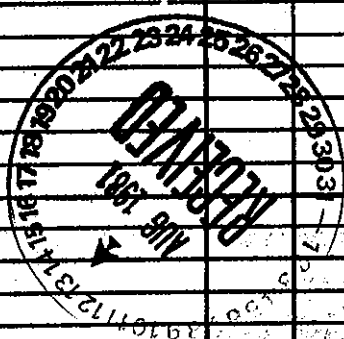

DRILLERS REMARKS: