


BoLEVAR  
Q-10.3  
1/5/81

MISSISSIPPI  
 BOARD OF WATER COMMISSIONERS  
 416 North State Street  
 Jackson, Mississippi 39201

WATER WELL DRILLERS LOG

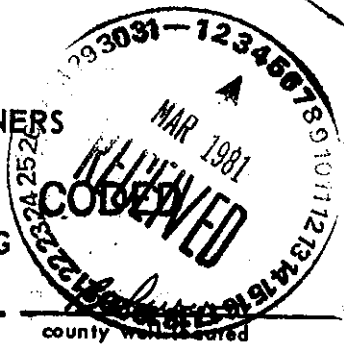

1-5-81 19 Sidney Cook Drilling Co. firm name  
 date well completed county well located

LANDOWNER:  
David Hershup  
 (mailing address)

description of formations encountered	from	to
<u>Clay</u>	<u>Top</u>	<u>12'</u>
<u>fine sand</u>	<u>12'</u>	<u>55'</u>
<u>sand &amp; gravel</u>	<u>55'</u>	<u>215'</u>

WELL LOCATION:  
 sec 20 T 22 N R 5 W  
1 miles South of Boyle miles  
 (distance) (direction) (nearest town)

WELL PURPOSE:  
 (home, irrigation, municipal, industrial)

- WELL COMPLETION DATA:
- (1) diameter (inches) 16"
  - (2) total depth (feet) 115'
  - (3) static water level (feet) 32' below above top of ground.
  - (4) casing Steel 75'  
 (material) (depth)  
4" (size) if telescope see back.
  - (5) screen 16" 75'  
 (length) (depth to top)  
16" Steel  
 (size) (material)
  - (6) pump 60HP 2400  
 (HP) (yield gpm)  
Power unit  
 (type power)
  - (7) electric log (yes or no)

**CODED**

DEPT. OF NATURAL RESOURCES  
 BUREAU OF LAND & WATER RESOURCES

MAR - 4 1981

**RECEIVED**

(organization running log)  
 (8) how well bottom plugged plate  
 DRILLERS REMARKS: