

BOLIVAR

CL-1775

170

april or
may 1981

MISSISSIPPI DEPARTMENT OF NATURAL RESOURCES

Bureau of Land and Water Resources

Southport Mall

P.O. Box 10631

Jackson, Mississippi 39209

WATER WELL DRILLERS LOG

CODED

LAYNE-CENTRAL COMPANY

BOLIVAR

date well completed

firm name

county well located

LANDOWNER:

Lyons Brothers Farm

Shaw, MS

(mailing address)

description of formations encountered

from

to

clay

0

32

clay

32

36

coarse sand

36

42

coarse sand-gravel

42

52

coarse sand-gravel

52

62

coarse sand-gravel

62

82

coarse sand-gravel

82

102

coarse sand-gravel

102

114

fine sand

114

117

WELL LOCATION:


sec. 24 T. 21 N. R. 5 E. S. 4
(distance) miles (direction) of Boyle (nearest town)

WELL PURPOSE: irrigation
(home, irrigation, municipal, industrial)

WELL COMPLETION DATA:

- (1) diameter (inches) 32"
- (2) total depth (feet) 117'
- (3) static water level (feet) 23' below above top of ground.
- (4) casing steel 64' (material), (depth) 16" (size) if telescope see back.
- (5) screen 50' 67' (length), (depth to top) 16" (size), st. steel (material)
- (6) pump 50 (HP) 2400 (yield gpm) GLEK (type power)
- (7) electric log no (yes or no)
(organization running log)
- (8) how well bottom plugged st. plage

CODED

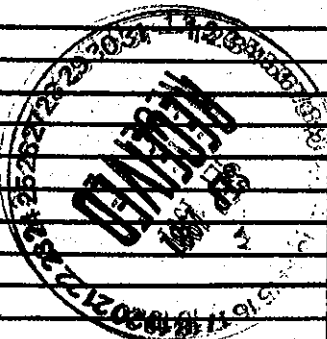

DRILLERS REMARKS: