

MISSISSIPPI DEPARTMENT OF NATURAL RESOURCES

Bureau of Land and Water Resources

Southport Mall

P.O. Box 10631

Jackson, Mississippi 39209

WATER WELL DRILLERS LOG

CODED

Bolivar  
Q-790-1079  
CL-18083-26-81


3-26 1981 Layne Central Company Bolivar  
 date well completed firm name county well located

LANDOWNER:	description of formations encountered	from	to
Charles Wilson			
Rt. 1 Beulah, MS 38725 (mailing address)	Sand	17	55
	Coarse sand	55	63
	Coarse sand & P. gr.	63	86
	Coarse sand & Gr.	86	105
	Coarse sand	105	111
	Coarse sand / gravel	111	122

WELL LOCATION:  
 sec 16 T 21 N R 7 E  
5 miles NE of Benoit  
 (distance) (direction) (nearest town)

WELL PURPOSE: irrigation  
 (home, irrigation, municipal, industrial)

- WELL COMPLETION DATA:
- (1) diameter (inches) 32"
  - (2) total depth (feet) 122'
  - (3) static water level (feet) 22' below top of ground.
  - (4) casing Steel 72'  
 (material) (depth)  
16" if telescope see back.  
 (size)
  - (5) screen 50 72'  
 (length) (depth to top)  
16 Doerr  
 (size) (material)
  - (6) pump 60 2500  
 (HP) (yield gpm)  
electric  
 (type power)
  - (7) electric log no  
 (yes or no)  
none  
 (organization running log)
  - (8) how well bottom plugged steel plated

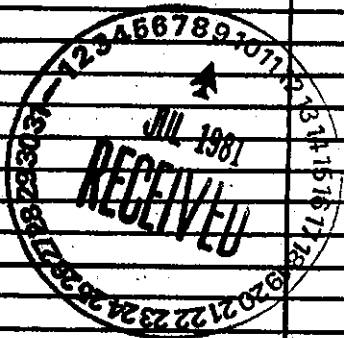

DRILLERS REMARKS: