

BOLIVAR MISSISSIPPI BOARD OF WATER COMMISSIONERS

R 26

2-16-64

WATER WELL DRILLERS LOG **1736**

Date: Feb. 16, 1964, Driller: Layne-Central Company, Bolivar

(Name)

(1) Owner of Land: <u>Delta & Pine Land Co.</u> (Name)	Description & Color of Materials Sand, Clay, Red Clay, Shell, etc.	Thick- ness Feet	Depth Feet
<u>Scott, Mississippi</u>	Top soil	5	5
(Address) <u>T20N</u>	Clay	4	9
(2) Location: <u>1/4, 1/4, Sec. 26 T. 20N</u>	Fine powder sand	13	22
<u>Belmont Plantation</u>	Fine sand	20	42
<u>_____</u> miles, of <u>Scott</u>	Coarse sand	26	68
(distance) (direction) (Nearest Town)	Coarse sand, pea gravel	17	85
(3) Topography: <u>flat</u>	Coarse sand, gravel with		
(Hilly) (Flat) (Level)	<u>just a few clay</u> CODED	7	92
(4) Purpose of Well: <u>irrigation</u>	Gravel, big boulders	33	125
(Domestic Irrigation, Municipal, Industrial, Other)			


Information upon completion of well:

- (1) Diameter 16 inches.
- (2) Total Depth 127 feet.
- (3) Water Level 9' - 4" feet below top of ground.
- (4) Cased to 77', Size 16"
- (5) Screen: Size 16", Length 50'
- (6) Were any formations sealed against pollution?
_____ yes, no no.

If YES depth of formation _____

Why _____

Drillers Remarks: _____

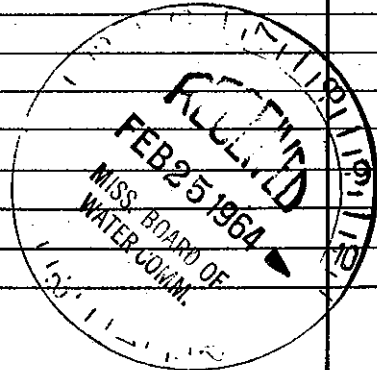

(Use Back Side)

Well No.

Mail this copy to Board of Water Commissioners 429 Miss. St. Jackson, Miss.