

BOLIVAR

MISSISSIPPI BOARD OF WATER COMMISSIONERS

R-32

WATER WELL DRILLERS LOG

Near R
CODED

6-24-60

Date: June 24, 1960, Driller: Layne-Central Co. County Bolivar


(Name)

		Description & Color of Materials <small>Sand, Clay, Red Clay, Shell, etc.</small>	Thick- ness Feet	Depth Feet
(1) Owner of Land: <u>Delta & Pine Land Co.</u> <small>(Name)</small>		<u>Clay</u>	<u>12</u>	<u>12</u>
<u>Scott, Mississippi</u> <small>(Address)</small>		<u>Sand</u>	<u>10</u>	<u>22</u>
(2) Location: <u>1/4, 1/4, Sec. 22 R 9</u> <u>Isole Plantation</u>		<u>Pea gravel</u>	<u>20</u>	<u>42</u>
<u>4</u> miles <u>West</u> of <u>Scott</u> <small>(distance) (direction) (Nearest Town)</small>		<u>Coarse sand</u>	<u>43</u>	<u>85</u>
(3) Topography: <u>X</u> <small>(Hilly) (Flat) (Level)</small>		<u>Gravel</u>	<u>16</u>	<u>101</u>
(4) Purpose of Well: <u>irrigation</u> <small>(Domestic Irrigation Municipal, Industrial, Other)</small>				

Information upon completion of well:

- (1) Diameter 16" inches. 102'
- (2) Total Depth 102' feet.
- (3) Water Level 17'-3" feet below top of ground.
- (4) Cased to 52', Size 16"
- (5) Screen: Size 16", Length 50'
- (6) Were any formations sealed against pollution?
_____ yes, _____ no.

CODED

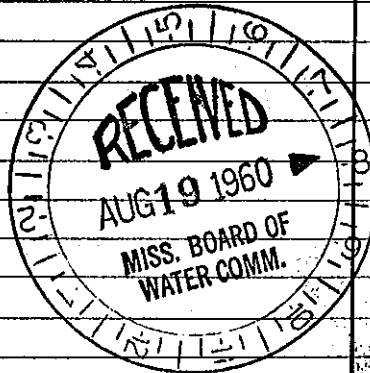

If YES depth of formation _____

Why _____

Drillers Remarks: _____

Well No. _____

(Use Back Side)

Mail this copy to Board of Water Commissioners 429 Miss. St. Jackson, Miss