

BOLIVAR MISSISSIPPI BOARD OF WATER COMMISSIONERS


R 34

7-14-64

WATER WELL DRILLERS LOG

Date: 7/14, 1964, Driller: Boley Drilling Co **CODED** Stringtown
(Name)

| (1) Owner of Land: <u>Sam Sterling</u> <small>(Name)</small> | Description & Color of Materials Sand, Clay, Red Clay, Shell, etc. | Thick- ness Feet | Depth Feet |
|---|---|------------------------|----------------|
| <u>Stringtown Miss.</u> <small>(Address)</small> | <u>Clay</u> | | <u>60</u> |
| (2) Location: <u>1/4, 1/4, Sec. 27 T20R8,</u> <u>SE</u> <u>4</u> miles <u>SE</u> of <u>Stringtown</u> <small>(distance) (direction) (Nearest Town)</small> | <u>Gravel</u> | | <u>80</u> |
| (3) Topography: <u>Flat</u> <small>(Hilly) (Flat) (Level)</small> | <u>Mud</u> | | <u>100</u> |
| (4) Purpose of Well: <u>Domestic</u> <small>(Domestic Irrigation Municipal, Industrial, Other)</small> | <u>Sand</u> | | <u>250</u> |
| Information upon completion of well: | <u>Mud</u> | | <u>294</u> |
| (1) Diameter <u>2</u> inches. | <u>Rock</u> | | <u>340</u> |
| (2) Total Depth <u>470</u> feet. | <u>Mud</u> | | <u>340 1/2</u> |
| (3) Water Level <u>40</u> feet below top of ground. | <u>Mud + Sand</u> | | <u>358</u> |
| (4) Cased to <u>all way</u> Size <u>2</u> | <u>Mud</u> | | <u>380</u> |
| (5) Screen: Size <u>2</u> CODED | <u>Mud + Sand</u> | | <u>400</u> |
| (6) Were any formations sealed against pollution? | <u>Mud</u> | | <u>436</u> |
| _____ yes, <u>X</u> no. | <u>Rock</u> | | <u>436 1/2</u> |
| If YES depth of formation _____ | <u>Mud</u> | | <u>462</u> |
| Why _____ | <u>Sand</u> | | <u>470</u> |
| Drillers Remarks: _____ | | | |
| _____ | | | |
| _____ | | | |
| _____ | | | |
| _____ | | | |

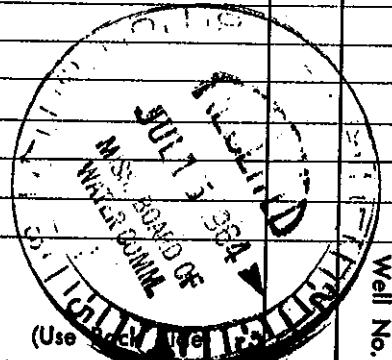

Well No. _____

Mail this copy to Board of Water Commissioners 429 Miss. St. Jackson, Miss.