

BOLIVAR  
R 35

MISSISSIPPI BOARD OF WATER COMMISSIONERS

11-22-65

WATER WELL DRILLERS LOG

**CODED**

Date: 11/22, 1965, Driller: Bailey Drly Co County: Stringtown  
(Name)

(1) Owner of Land:	Description & Color of Materials Sand, Clay, Red Clay, Shell, etc.	Thick- ness Feet	Depth Feet
<u>B E Stewart</u> (Name) <u>Stringtown, Miss.</u> (Address)	<u>Clay</u>		<u>19</u>
(2) Location: <u>1/4</u> , <u>1/4</u> , Sec. <u>24</u> <u>20RB</u> , <u>2</u> miles <u>NE</u> of <u>Stringtown</u> (distance) (direction) (Nearest Town)	<u>Sand</u>		<u>120</u>
(3) Topography: <u>Flat</u> (Hilly) (Flat) (Level)	<u>Gravel</u>		<u>140</u>
(4) Purpose of Well: <u>domestic</u> (Domestic Irrigation Municipal, Industrial, Other)	<u>Mud</u>		<u>441</u>
	<u>Sand</u>		<u>482</u>

Information upon completion of well:


- (1) Diameter 2 1/2 X 2 inches.
- (2) Total Depth 482 feet.
- (3) Water Level 29 feet below ground.
- (4) Cased all way, Size 2 1/2 X 2.
- (5) Screen: Size 2, Length 8 ft.
- (6) Were any formations sealed against pollution?  
no.

**CODED**

If YES, depth of formation \_\_\_\_\_

Why \_\_\_\_\_

Drillers Remarks: \_\_\_\_\_

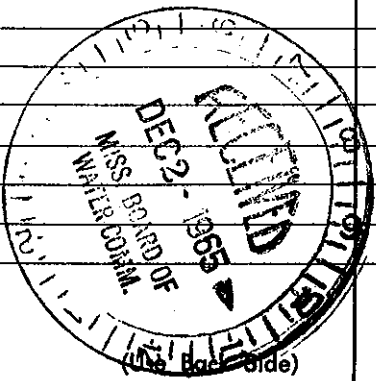

Well No.

Mail this copy to Board of Water Commissioners 429 Miss. St. Jackson, Miss.