

Bolivar
R37

MISSISSIPPI BOARD OF WATER COMMISSIONERS

3-66

WATER WELL DRILLERS LOG

Bolivar

Date: 3-30-66, 1966, Driller: Fiddley Lemuel Cochran
(Name)

CODED

(1) Owner of Land:	Description & Color of Materials Sand, Clay, Red Clay, Shell, etc.	Thick- ness Feet	Depth Feet
Delta & Lewis Land Co (Name)	Topsoil & Sand		14
SCOTT Miss (Address)	Sand	13	27
(2) Location: 1/4, 1/4, Sec. 19 T20R8	Sand & Gravel	78	111 1/2
3 miles South of Scott (distance) (direction) (Nearest Town)			
(3) Topography: Flat (Hilly) (Flat) (Level)			
(4) Purpose of Well: Irrigation (Domestic, Irrigation, Municipal, Industrial, Other)			


Information upon completion of well:

- (1) Diameter ~~4~~ 6 inches.
- (2) Total Depth 106 feet.
- (3) Water Level 10 feet below top of ground.
- (4) Cased to 58' 2" Size 6
- (5) Screen: Size 6, Length 48'
- (6) Were any formations sealed against pollution?
_____ yes, _____ no.

CODED

If YES depth of formation _____
Why _____

Drillers Remarks: _____

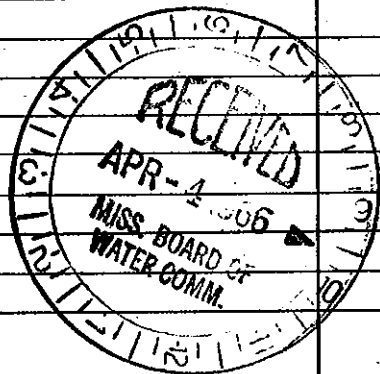

(Use Back Side)

Well No. 6

Mail this copy to Board of Water Commissioners 429 Miss. St. Jackson, Miss.