

Bolivar
R 39
3-66

MISSISSIPPI BOARD OF WATER COMMISSIONERS


WATER WELL DRILLERS LOG

CODED

Date: 3-29, 1966, Driller: Live County Farm Live County Arkansas
(Name)

(1) Owner of Land: <u>DELTA + PINELAND Co</u> (Name)	Description & Color of Materials Sand, Clay, Red Clay, Shell, etc.	Thick- ness Feet	Depth Feet
<u>SCOTT MISS</u> (Address)	<u>Sandy loam</u>		<u>14</u>
	<u>Fine sand</u>	<u>6 1/2</u>	<u>20 1/2</u>
	<u>Sand</u>	<u>6 1/2</u>	<u>27 1/2</u>
(2) Location: <u>1/4</u> , <u>1/4</u> , Sec. <u>7 T20R8</u>	<u>Fine Sand</u>	<u>6 1/2</u>	<u>34 1/2</u>
<u>1/2</u> miles <u>South</u> , of <u>SCOTT</u> (distance) (direction) (Nearest Town)	<u>Med Sand</u>	<u>13</u>	<u>46 1/2</u>
(3) Topography: <u>Flat</u> (Hilly) (Flat) (Level)	<u>Blue Clay</u>	<u>6 1/2</u>	<u>53</u>
(4) Purpose of Well: <u>Irrigation</u> (Domestic Irrigation Municipal, Industrial, Other)	<u>Med Sand</u>	<u>26</u>	<u>79</u>
	<u>Sand & gravel</u>	<u>3 1/2</u>	<u>111 1/2</u>
Information upon completion of well:			
(1) Diameter <u>6</u> inches.			
(2) Total Depth <u>106' 2"</u> feet.			
(3) Water Level <u>10'</u> feet below ground.			
(4) Cased to <u>58' 2"</u> , Size <u>6"</u>			
(5) Screen: Size <u>6"</u> , Length <u>48'</u>			
(6) Were any formations sealed against pollution?			
_____ yes, _____ no.			
If YES depth of formation _____			
Why _____			
Drillers Remarks: _____			
<u>SC</u>			

CODED

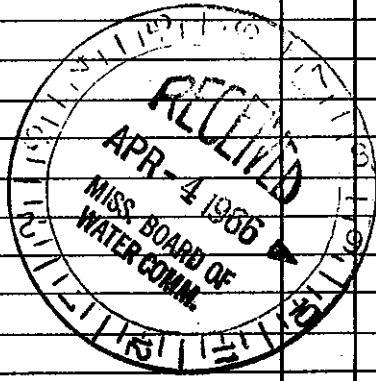

Well No. 5

(Use Back Side)

Mail this copy to Board of Water Commissioners 429 Miss. St. Jackson, Miss