

Bolivar
RAO
3-66

MISSISSIPPI BOARD OF WATER COMMISSIONERS

WATER WELL DRILLERS LOG

CODED
BOLIVAR

Date: Mar 24, 1966, Driller: Lee County Farmers Co. Bolivar
(Name)

(1) Owner of Land: DELTA & PINE LAND CO
(Name)
SCOTT MISS
(Address)

(2) Location: 1/4, 1/4, Sec. 12 T20R9
2 1/2 miles West, of SCOTT
(distance) (direction) (Nearest Town)

(3) Topography: Flat
(Hilly) (Flat) (Level)

(4) Purpose of Well: Irrigation
(Domestic, Irrigation, Municipal, Industrial, Other)

Description & Color of Materials Sand, Clay, Red Clay, Shell, etc.	Thick- ness Feet	Depth Feet
Clay	14	
Brown Sand	6 1/2	20 1/2
Very Mucky Sand	13	33 1/2
Med Grey Sand	6 1/2	40
Coarse Sand	6 1/2	46 1/2
Med Sand	13	59 1/2
Coarse Sand	13	72 1/2
Coarse Sand & Gravel	6 1/2	79
Sandy Gravel	32 1/2	111 1/2

Information upon completion of well:

(1) Diameter 6 inches.

(2) Total Depth 107 feet.

(3) Water Level 16 feet below top of ground.

(4) Cased to 59' Size 6

(5) Screen: Size 6, Length 48


(6) Were any formations sealed against pollution?
_____ yes, _____ no.

CODED

If YES depth of formation _____

Why _____

Drillers Remarks:
Doug Beatty

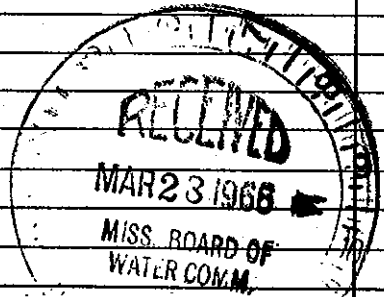

D. Beatty
(Use Back Side)

Well No. 2

Mail this copy to Board of Water Commissioners 429 Miss. St. Jackson, Miss