

Bolivar
R 41
3-66

MISSISSIPPI BOARD OF WATER COMMISSIONERS

WATER WELL DRILLERS LOG

CUBED
Bolivar

Date: 3-23, 1966, Driller: John County James County Bolivar
(Name)

(1) Owner of Land: <u>DELTA + PINE LAND CO</u> (Name)	Description & Color of Materials Sand, Clay, Red Clay, Shell, etc.	Thick- ness Feet	Depth Feet
<u>SCOTT MISS</u> (Address)	<u>Clay</u>	<u>14</u>	
(2) Location: <u>1/4, 1/4, Sec. 11 T20R9</u>	<u>Red Sand</u>	<u>13</u>	<u>27</u>
<u>3</u> miles <u>West</u> of <u>SCOTT</u> (distance) (direction) (Nearest Town)	<u>Grey Sand</u>	<u>13</u>	<u>40</u>
(3) Topography: <u>Flat</u> (Hilly) (Flat) (Level)	<u>Med Sand</u>	<u>26</u>	<u>59 1/2</u>
(4) Purpose of Well: (Domestic Irrigation, Municipal, Industrial, Other)	<u>Med Sand + lignite</u>	<u>6 1/2</u>	<u>72 1/2</u>
	<u>Sand + gravel</u>	<u>33 1/2</u>	<u>105</u>
	<u>SOLID ROCK</u>	<u>3</u>	<u>108</u>

Information upon completion of well:

(1) Diameter 6 inches.

(2) Total Depth 100^{3"} feet.

(3) Water Level 16 feet below top of ground.

(4) Cased to 52^{3"} **CUBED**

(5) Screen: Size 6", Length 48


(6) Were any formations sealed against pollution?
_____ yes, _____ no.

If YES depth of formation _____

Why _____

Drillers Remarks:
Daugherty

J. Adams

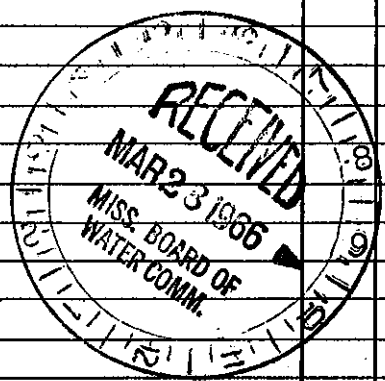

Well No. 1

(Use Back Side)

Mail this copy to Board of Water Commissioners 429 Miss. St. Jackson, Miss