

BOLIVAR

MISSISSIPPI BOARD OF WATER COMMISSIONERS

CODED *code*

R 51

WATER WELL DRILLERS LOG


3/11/62 C1223

3-9-62

Date: March 9, 1962, Driller: Layne-Central Company County Bolivar

(Name)

(1) Owner of Land: Mills Brothers (Name)	Description & Color of Materials Sand, Clay, Red Clay, Shell, etc.	Thick- ness Feet	Depth Feet
Benoit, Mississippi (Address)	Clay	18	18
(2) Location: 1/4, 1/4, Sec. 29 T. 21N. R. 7W	Fine sand	26	44
3 miles west of Stringtown (distance) (direction) (Nearest Town)	Coarse sand	14	58
(3) Topography: flat (Hilly) (Flat) (Level)	Coarse sand, pea gravel	36	94
(4) Purpose of Well: irrigation (Domestic Irrigation Municipal, Industrial, Other)	Big gravel, sand	26	120
Information upon completion of well:	Big boulders	6	126
(1) Diameter 16 inches.	clay CODED		126
(2) Total Depth 126 feet.			
(3) Water Level 10' - 2" feet below top of ground.			
(4) Cased to 56', Size 16"			
(5) Screen: Size 16", Length 70'			
(6) Were any formations sealed against pollution? yes, no no.			
If YES depth of formation _____			
Why _____			
Drillers Remarks: _____			

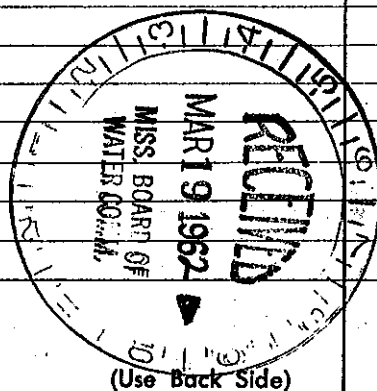

Well No.

Mail this copy to Board of Water Commissioners 429 Miss. St. Jackson, Miss