

**BOLIVAR**

MISSISSIPPI BOARD OF WATER COMMISSIONERS

Coded

**R 52**

**3-5-62**


**WATER WELL DRILLERS LOG** *COG 1/62 1252*

Date: March 5, 1962, Driller: Layne-Central Company County Bolivar

(Name)

(1) Owner of Land:	Description & Color of Materials Sand, Clay, Red Clay, Shell, etc.	Thick- ness Feet	Depth Feet
Delta & Pine Land Co	Hard sandy clay	8	8
Fallback Plantation.	Gumbo clay	33	41
Scott, Mississippi	Fine sand	21	62
(Address) T20N	Coarse sand	20	82
(2) Location: 1/4, 1/4, Sec. 23 T. R. 8W	Coarse sand, pea rock	15	97
5 miles east of Scott	Gravel sand	8	105
(distance) (direction) (Nearest Town)	Clay		105
(3) Topography: flat			
(Hilly) (Flat) (Level)			
(4) Purpose of Well: irrigation			
(Domestic Irrigation Municipal, Industrial, Other)			
Information upon completion of well:			
(1) Diameter. 16 inches.			
(2) Total Depth. 105 feet.			
(3) Water level. 6' - 3" feet below top of ground.			
(4) Cased to. 65', Size 16"			
(5) Screen: Size 16", Length 40'			
(6) Were any formations sealed against pollution?			
yes, no no.			
If YES depth of formation			
Why			
Drillers Remarks:			

**CODED**

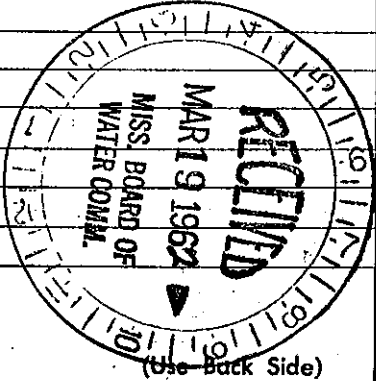

Well No.

Mail this copy to Board of Water Commissioners 429 Miss. St. Jackson, Miss